

MONROE  
B50  
6-23-72

MISSISSIPPI  
BOARD OF WATER COMMISSIONERS  
416 North State Street  
Jackson, Mississippi 39201

WATER WELL DRILLERS LOG

**CODED**

6/23 1972 Herman Homan Well & Supply, Inc. Monroe  
date well completed P.O. No. 42 county well located

SHANNON, MISSISSIPPI 38668

LANDOWNER:  
James Homan, Cutt  
Box 13, Oshtobla, Miss  
(mailing address)

description of formations encountered	from	to
Surface sand & clay	0	32
Blue clay	32	200
Sand	200	340
Bottom	340	

WELL LOCATION:  
sec. 31 T. 12 R. 7 E  
1 miles N of New Wren  
(distance) (direction) (nearest town)

WELL PURPOSE: Home  
(home, irrigation, municipal, industrial)

- WELL COMPLETION DATA:
- (1) diameter (inches) 5"
  - (2) total depth (feet) 340'
  - (3) static water level (feet) 100' below top of ground
  - (4) casing Steel, 38', (depth)
  - 5' if telescope see back. (size)
  - (5) screen 20' (length), (depth to top)
  - (size) (material)
  - (6) pump 1/2 HP, 5 (yield gpm)
  - electric (type power)
  - (7) electric log no (yes or no)
  - (organization running log)
  - (8) how well bottom plugged open


**CODED**

DRILLERS REMARKS:

JUL 13 1972

If well telescopes please sketch and show depths.

GROUND LEVEL

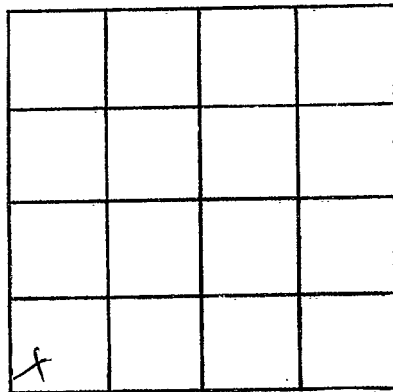

SECTION 31

Please indicate well location X.

ADDITIONAL INFORMATION

If more than one screen, show locations of each on sketch.