

**MONROE**  
**B51**  
**2-3-72**

MISSISSIPPI  
BOARD OF WATER COMMISSIONERS  
416 North State Street  
Jackson, Mississippi 39201

WATER WELL DRILLERS LOG **CODED**

Feb. 3 1972 Leeper Drilling Co. MONROE  
date well completed firm name county well located

LANDOWNER: Eddie WALKER

description of formations encountered from to

Box 280  
Nettleton Mississippi  
(mailing address)

Red Clay	0	20 ft
Red Sand	21	45
SOAP STONE	46	80
EUTAW SAND	81	130
SOAPSTONE	131	135

WELL LOCATION:

sec. 12 T. 12 N. R. 9 E. W. 5  
2 1/2 miles S.E. of Nettleton  
(distance) (direction) (nearest town)

WELL PURPOSE: Home  
(home, irrigation, municipal, industrial)

WELL COMPLETION DATA:

- (1) diameter (inches) 4"
- (2) total depth (feet) 135 ft.
- (3) static water level (feet) 65' below above top of ground.
- (4) casing Steel 63'  
(material) (depth)  
4" if telescope see back.  
(size)
- (5) screen NONE  
(length) (depth to top)  
(size) (material)
- (6) pump 1/2 7 GPM  
(HP) (yield gpm)  
electric  
(type power)
- (7) electric log NO  
(yes or no)  
(organization running log)
- (8) how well bottom plugged OPEN

**CODED**


JAN 12 1972

DRILLERS REMARKS:

MISS. DL.  
WELL LOG

If well telescopes please sketch and show depths.

GROUND LEVEL

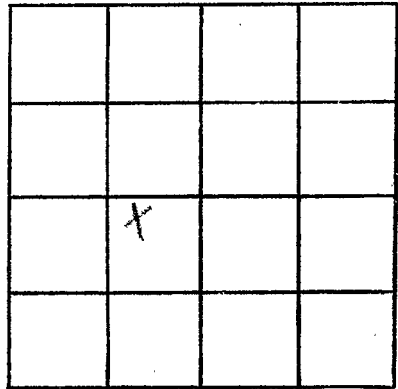

SECTION 23

Please indicate well location X.

ADDITIONAL INFORMATION

Horizontal lines for additional information.

If more than one screen, show locations of each on sketch.