

MONROE
B52
8-29-72

MISSISSIPPI
 BOARD OF WATER COMMISSIONERS
 416 North State Street
 Jackson, Mississippi 39201

CODED

WATER WELL DRILLERS LOG

8/29 1972 Herman Homan Well & Supply, Inc. Monroe
 date well completed P.O. Box 42 county well located

SHANNON MISSISSIPPI 38508

LANDOWNER: <u>RFR Development</u>	Description of formations encountered	from	to
<u>Bobby Headrick</u>	<u>Surface sand & clay</u>	<u>0</u>	<u>18</u>
<u>Netleton Miss.</u>	<u>Blue clay</u>	<u>18</u>	<u>100</u>
(mailing address)	<u>Sand</u>	<u>100</u>	<u>220</u>
	<u>Bottom</u>	<u>220</u>	

WELL LOCATION:
 sec. 31 T. 11 N. R. 7 E.
 S W
1/2 miles E of Netleton
 (distance) (direction) (nearest town)

WELL PURPOSE: Home
 (home, irrigation, municipal, industrial)

WELL COMPLETION DATA:

- diameter (inches) 5"
- total depth (feet) 220
- static water level (feet) 40' below top of ground.
- casing Steel, 22' 4" (material), (depth)
5" if telescope see back. (size)
- screen no, (length), (depth to top)
 (size), (material)
- pump 3/4, 4 (HP), (yield gpm)
electric (type power)
- electric log no (yes or no)
 (organization running log)
- how well bottom plugged open

CODED


DRILLERS REMARKS: _____

SEP 8 1972

MISS. Bd. of
 WATER COMMISSIONERS

If well telescopes please sketch and show depths.

GROUND LEVEL

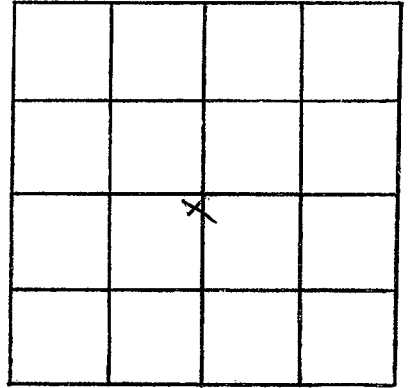

SECTION 31

Please indicate well location X.

ADDITIONAL INFORMATION

If more than one screen,
show locations of each on sketch.