

MONROE
B54
7-29-73

MISSISSIPPI
BOARD OF WATER COMMISSIONERS
416 North State Street
Jackson, Mississippi 39201

CODED

WATER WELL DRILLERS LOG

7/28 1973 Herman Homan Well & Supply, Inc. Monroe
date well completed firm name county well located
P.O. Box #2
SHANNON MISSISSIPPI 38668

LANDOWNER:
A. L. Lowery
Nettleton Miss.
(mailing address)

description of formations encountered	from	to
Surface sand + clay	0	23
Shale	23	80
Sand	80	180
Butta	180	

WELL LOCATION:
sec. 8 T. 11 N. R. 2 E.
1/4 miles E of Nettleton
(distance) (direction) (nearest town)

WELL PURPOSE: Home
(home, irrigation, municipal, industrial)

- WELL COMPLETION DATA:
- (1) diameter (inches) 5"
 - (2) total depth (feet) 180'
 - (3) static water level (feet) 80 below top of ground.
 - (4) casing Steel 27' 8"
(material) (depth)
5" If telescope see back.
(size)
 - (5) screen no
(length) (depth to top)
(size) (material)
 - (6) pump no
(HP) (yield gpm)
(type power)
 - (7) electric log no
(yes or no)
(organization running log)
 - (8) how well bottom plugged open



CODED

DRILLERS REMARKS:

SEP 8/1973

If well telescopes please sketch and show depths.

GROUND LEVEL

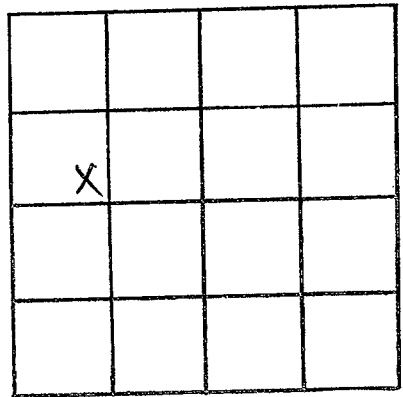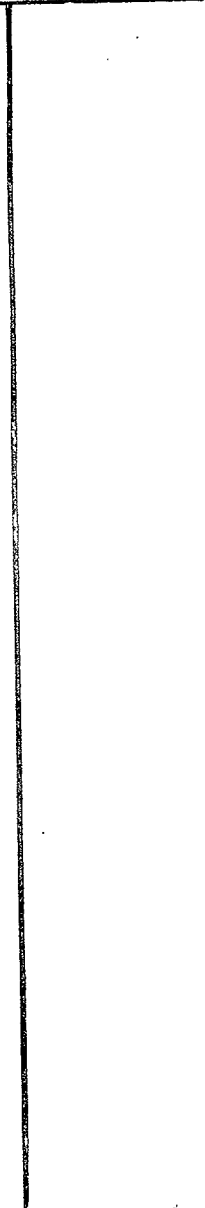

SECTION 31

Please indicate well location X.

ADDITIONAL INFORMATION

Lined area for additional information.

If more than one screen, show locations of each on sketch.