

MONROE
B 55
10-26-73

MISSISSIPPI
BOARD OF WATER COMMISSIONERS
416 North State Street
Jackson, Mississippi 39201

WATER WELL DRILLERS LOG

Herman Homan Well & Supply, Inc.

CORED
Monroe

10-26-1973
date well completed

P.O. Box 42
firm name

county well located

SHANNON, MISSISSIPPI 38868

LANDOWNER:
Lillian Freshour
Natchitoches, Miss
(mailing address)

description of formations encountered	from	to
Surface sand & clay	0	16
Blue clay	16	80
Sand	80	180
Bottom	180	

WELL LOCATION:
sec. 31 T-11 N R-7 E
S
1/2 miles E of Natchitoches
(distance) (direction) (nearest town)

WELL PURPOSE:
Home
(home, irrigation, municipal, industrial)

- WELL COMPLETION DATA:
- (1) diameter (inches) 5 1/4
 - (2) total depth (feet) 180'
 - (3) static water level (feet) 30' below top of ground.
 - (4) casing Steel 21' (material) (depth)
5 1/4 (size) if telescope see back.
 - (5) screen ND (length) (depth to top)
(size) (material)
 - (6) pump 1 (HP) 5 (yield gpm)
electric (type power)
 - (7) electric log ND (yes or no)
(organization running log)
 - (8) how well bottom plugged open


CORED

DRILLERS REMARKS:

NOV 26 1973

If well telescopes please sketch and show depths.

GROUND LEVEL

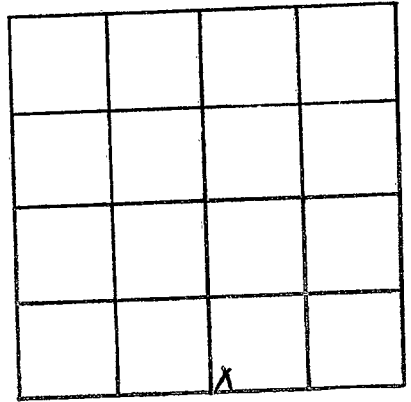

SECTION 31

Please indicate well location X.

ADDITIONAL INFORMATION

If more than one screen,
show locations of each on sketch.