

MONROE
B 56
2-28-74

MISSISSIPPI
BOARD OF WATER COMMISSIONERS
416 North State Street
Jackson, Mississippi 39201

WATER WELL DRILLERS LOG

CODED

2-28 1974 Herman Homan Well & Supply, Inc. Monroe
date well completed film frame 42 county well located
SHANNON MISSISSIPPI 38668

LANDOWNER: JAN Green contact

Thomas Dold
Nettleton, Miss.
(mailing address)

description of formations encountered	from	to
<u>Surface sand</u>	<u>0</u>	<u>20</u>
<u>Blue clay</u>	<u>20</u>	<u>80</u>
<u>Sand</u>	<u>80</u>	<u>200</u>
<u>Bottom</u>	<u>200</u>	

WELL LOCATION:

sec. 31 T. 11 N. R. 7 E
1/4 miles S of Nettleton
(distance) (direction) (nearest town)

WELL PURPOSE: Nettleton
(home, irrigation, municipal, industrial)


WELL COMPLETION DATA:

- (1) diameter (inches) 5"
- (2) total depth (feet) 200'
- (3) static water level (feet) 50 below above top of ground.
- (4) casing steel 26'4"
(material) (depth)
5" if telescope see back.
(size)
- (5) screen ND
(length) (depth to top)
(size) (material)
- (6) pump 1/2 5
(HP) (yield gpm)
electric
(type power)
- (7) electric log ND
(yes or no)

(organization running log)

(8) how well bottom plugged open

CODED

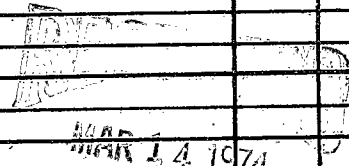

DRILLERS REMARKS:

MISS. BD. OF WATER COMM

