

MONROE  
B57  
4-18-74

MISSISSIPPI  
BOARD OF WATER COMMISSIONERS  
416 North State Street  
Jackson, Mississippi 39201

WATER WELL DRILLERS LOG

Herman Homan Well & Supply, Inc.

CODED

4-18-74  
date well completed

P. O. Box 42

SHANNON, MISSISSIPPI 38668

Monroe  
county well located

LANDOWNER:

John R. Segmore  
Natteton, Miss.  
(mailing address)

description of formations encountered

Surface Sand  
Clay  
Blue clay  
Sand  
Bottom

from to

0 12  
12 40  
40 190  
190

WELL LOCATION:

sec. 9 T. 14 N. R. 7 E  
S W  
2 1/2 miles SE of Natteton  
(distance) (direction) (nearest town)

WELL PURPOSE:

Home  
(home, irrigation, municipal, industrial)

WELL COMPLETION DATA:

- (1) diameter (inches) 5"
- (2) total depth (feet) 190'
- (3) static water level (feet) 22' below top of ground
- (4) casing Steel 1 1/2" (material), 18' (depth)  
5" if telescope see back.  
(size)
- (5) screen ND (length), (depth to top)  
(size) (material)
- (6) pump ND (HP) (yield gpm)  
(type power)
- (7) electric log ND (yes or no)  
(organization running log)
- (8) how well bottom plugged open

CODED


DRILLERS REMARKS:

MAY 17 1974

MISS. BLDG. OF WATER COMMISSIONERS

If well telescopes please sketch and show depths.

GROUND LEVEL

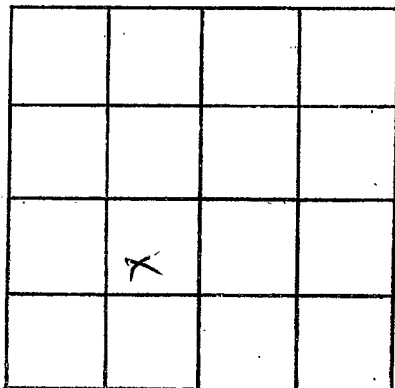

SECTION   f  

Please indicate well location X.

ADDITIONAL INFORMATION

If more than one screen,  
show locations of each on sketch.