

MONROE
B58
4-15-74

MISSISSIPPI
BOARD OF WATER COMMISSIONERS
416 North State Street
Jackson, Mississippi 39201

WATER WELL DRILLERS LOG

CODED

4/15 1974 date well completed
Herman Homan Well & Supply, Inc.
P.O. Box 42
SHANNON, MISSISSIPPI 38606
MONROE county well located

LANDOWNER:

F.T. Smith
Rt 2 Nettleton, Miss
(mailing address)

description of formations encountered

description of formations encountered	from	to
Surface sand &	0	16
clay	16	100
blue clay	100	200
sand	200	
bottom		

WELL LOCATION:

sec. 20 T12N R 7E
S
3 1/2 miles SE of Nettleton
(distance) (direction) (nearest town)

WELL PURPOSE:

(home, irrigation, municipal, industrial)

WELL COMPLETION DATA:

- (1) diameter (inches) 5 1/4
- (2) total depth (feet) 200
- (3) static water level (feet) 60 below top of ground.
- (4) casing steel, 21 ft (material) (depth)
5 1/4 (size) if telescope see back.
- (5) screen NO (length) (depth to top)
(size) (material)
- (6) pump 1 (HP) 5 (yield gpm)
electric (type power)
- (7) electric log NO (yes or no)
(organization running log)
- (8) how well bottom plugged open


CODED

DRILLERS REMARKS:

MISS. Bd. OF WATER COMMISSIONERS

If well telescopes please sketch and show depths.

GROUND LEVEL

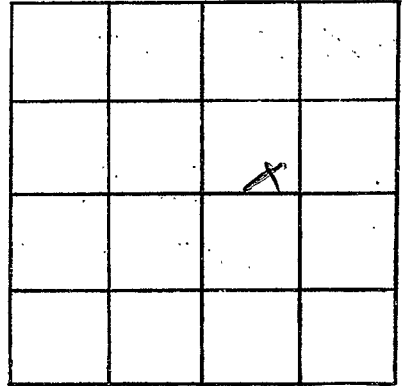

SECTION 20

Please indicate well location X.

ADDITIONAL INFORMATION

If more than one screen, show locations of each on sketch.