

MONROE
B59
4-15-74

MISSISSIPPI
BOARD OF WATER COMMISSIONERS
416 North State Street
Jackson, Mississippi 39201 CODED

WATER WELL DRILLERS LOG

4-15-19 74 date well completed
Herman Homan Well & Supply, Inc.
P. O. Box 42
SHANNON, MISSISSIPPI 38208
Monroe county well located

LANDOWNER:

Rog Smith
At E, Nettleton Miss
(mailing address)

description of formations encountered

Surface sand & clay 0 to 16
Blue clay 16 to 80
Sand 80 to 170
Bottom 170

from to

WELL LOCATION:

sec. 21 T. 12 N R. 7 E
S SE of Nettleton
4 miles (distance) (direction) (nearest town)

WELL PURPOSE: Home
(home, irrigation, municipal, industrial)


WELL COMPLETION DATA:

- (1) diameter (inches) 5 9
- (2) total depth (feet) 170
- (3) static water level (feet) 40 below top of ground
- (4) casing steel, 20' 4" (material) (depth)
5 2 (size) if telescope see back.
- (5) screen NO (length) (depth to top)
(size) (material)
- (6) pump 1 (HP) 5 (yield gpm)
clashon (type power)
- (7) electric log NO (yes or no)

CODED

(organization running log)


(8) how well bottom plugged Open

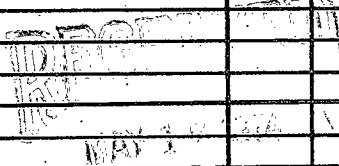

DRILLERS REMARKS:

If well telescopes please sketch and show depths.

GROUND LEVEL

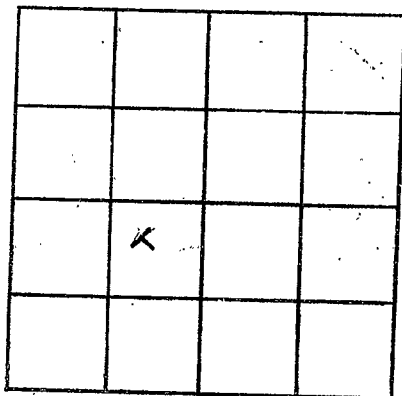

SECTION 21

Please indicate well location X.

ADDITIONAL INFORMATION

If more than one screen,
show locations of each on sketch.