

MONROE  
B60  
6-21-74

MISSISSIPPI  
BOARD OF WATER COMMISSIONERS  
416 North State Street  
Jackson, Mississippi 39201

CODED

WATER WELL DRILLERS LOG

Herman Heman Well & Supply, Inc.

6/21 1974

date well completed

P. O. Box 12

firm name

SHANNON, MISSISSIPPI 38868

Monroe county well located

LANDOWNER:

C. J. Fowles  
Nettletop Miss.  
(mailing address)

description of formations encountered

description of formations encountered	from	to
Surface sand & clay	0	25
Blue clay	25	80
Sand	80	200
Bottom	200	

WELL LOCATION:

sec. 31 T. 11 N. R. 7 E  
S 4  
1/2 miles E of Nettletop  
(distance) (direction) (nearest town)


WELL PURPOSE:

(home, irrigation, municipal, industrial)

WELL COMPLETION DATA:

- (1) diameter (inches) 5 1/2
- (2) total depth (feet) 200'
- (3) static water level (feet) 60 below top of ground.
- (4) casing steel, 28',  
(material) (depth)  
5 1/2" if telescope see back.  
(size)
- (5) screen no,  
(length) (depth to top)  
(size) (material)
- (6) pump 1 1/2 5  
(HP) (yield gpm)  
electric  
(type power)
- (7) electric log no  
(yes or no)
- (8) how well bottom plugged Open

DRILLERS REMARKS:

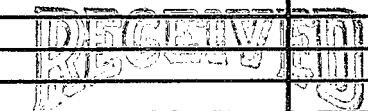


JUL 1 1974

MISS. BD. OF WATER COMM.

If well telescopes please  
sketch and show depths.

GROUND LEVEL

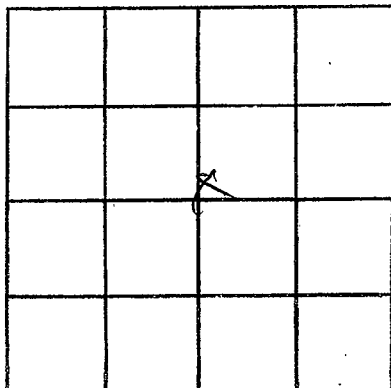

SECTION 31

Please indicate well location X.

ADDITIONAL INFORMATION

If more than one screen,  
show locations of each on sketch.