

MONROE
B63
7-8-74

MISSISSIPPI
BOARD OF WATER COMMISSIONERS
416 North State Street
Jackson, Mississippi 39201

CODED

WATER WELL DRILLERS LOG

7-8 1974 date well completed
Herman Homan Well & Supply, Inc. firm name
SHANNON MISSISSIPPI 38868
Monroe county well located

LANDOWNER:
Oleas Clark
RT 2 Nettleton Miss
(mailing address)

description of formations encountered	from	to
Surface sand		
& clay	0	35
Blue clay	35	90
sand	90	120
Bottom	120	

WELL LOCATION:
sec 34 T 11 N R 7 E S 4 W
3 1/2 miles E of Nettleton
(distance) (direction) (nearest town)

WELL PURPOSE: Home
(home, irrigation, municipal, industrial)

- WELL COMPLETION DATA:
- (1) diameter (inches) 4 1/2
 - (2) total depth (feet) 125
 - (3) static water level (feet) 40' below top of ground.
 - (4) casing Steel 91' (material) (depth)
4 1/2" (size) if telescope see back.
 - (5) screen NO (length) (depth to top)
(size) (material)
 - (6) pump 3/4 (HP) 5 (yield gpm)
oleas (type power)
 - (7) electric log NO (yes or no)
(organization running log)
 - (8) how well bottom plugged open

DRILLERS REMARKS:


CODED

RECEIVED
AUG 6 1974

MISS. Bd. OF WATER COMMISSIONERS

If well telescopes please sketch and show depths.

GROUND LEVEL

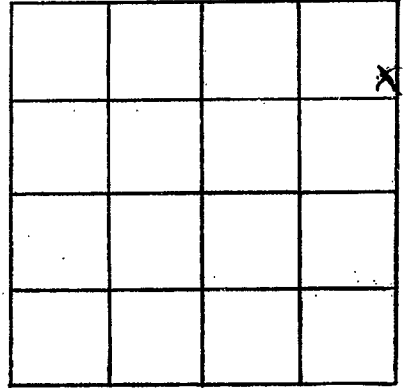

SECTION 34

Please indicate well location X.

ADDITIONAL INFORMATION

If more than one screen, show locations of each on sketch.