

Monroe
B 65
6-10-75

MISSISSIPPI
 BOARD OF WATER COMMISSIONERS
 416 North State Street
 Jackson, Mississippi 39201

CODED

WATER WELL DRILLERS LOG


6-10 19 75
 date well completed

Herman Homan Well & Supply, Inc.
 P. O. Box 42
 firm name

SHANNON, MISSISSIPPI 38868

Monroe
 county well located


LANDOWNER:	description of formations encountered	from	to
<u>Willie Roberts</u>	<u>surface sand</u>		
<u>Rt 2, Nettleton Miss.</u> (mailing address)	<u>+ clay</u>	<u>0</u>	<u>28</u>
	<u>shale clay</u>	<u>28</u>	<u>50</u>
	<u>sand</u>	<u>50</u>	<u>200</u>
	<u>bottom</u>	<u>200</u>	
WELL LOCATION: sec. <u>18</u> T. <u>24</u> N. R. <u>7</u> E. <u>130</u> S. W. <u>1</u> <u>2 1/2</u> miles <u>SE</u> of <u>Nettleton</u> (distance) (direction) (nearest town)			
WELL PURPOSE: <u>drain</u> (home, irrigation, municipal, industrial)			
WELL COMPLETION DATA: (1) diameter (inches) <u>4 1/4</u> (2) total depth (feet) <u>200</u> (3) static water level (feet) <u>27'</u> below top of ground. (4) casing <u>Steel</u> , <u>32 1/2"</u> (material) (depth) <u>4 1/2</u> if telescope see back. (size) (5) screen <u>no</u> (length) (depth to top) (size) (material) (6) pump <u>1</u> <u>5</u> (HP) (yield gpm) <u>electric</u> (type power) (7) electric log <u>no</u> (yes or no) (organization running log) (8) how well bottom plugged <u>open</u>			
DRILLERS REMARKS:			

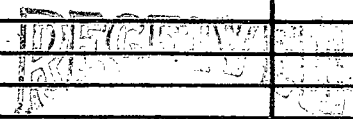

JUL - 2 1975

If well telescopes please sketch and show depths.

GROUND LEVEL

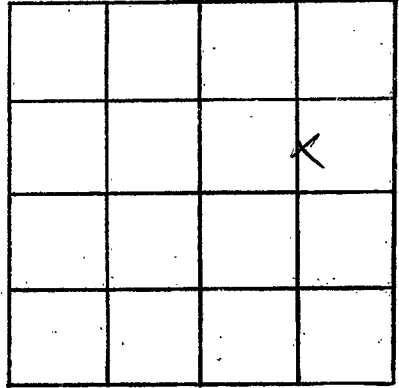

SECTION 18

Please indicate well location X.

ADDITIONAL INFORMATION

If more than one screen, show locations of each on sketch.