

B 300

WATER WELL DRILLERS LOG

Herndon Well & Supply Co.

Date: 12/27, 1960, Driller: SHANNON, MISS. County Monroe

(Name)

RODAUGH

9632663
(1) Owner of Land: H. W. Rodaugh
(Name)

Description & Color of Materials
Sand & Clay 2.0

Nettled, Miss.
(Address)

Blue Sand 2.5

(2) Location: 1/4, 1/4, Sec. 4 T. 12 S. R. 7 E

Sand

3 miles E, of Nettled
(distance) (direction) (Nearest Town)

Bottom 84

(3) Topography: Flat
(Hilly) (Flat) (Level)

(4) Purpose of Well: Home Use
(Domestic Irrigation
Municipal, Industrial, Other)

Information upon completion of well:

(1) Diameter 4 inches.

(2) Total Depth 84 feet.

(3) Water Level 10 feet below top of ground.

(4) Cased to 23', Size 4"


(5) Screen: Size , Length

(6) Were any formations sealed against pollution?
 yes, no.

If YES depth of formation 20 ft

Why Surface & Sand

Drillers Remarks:

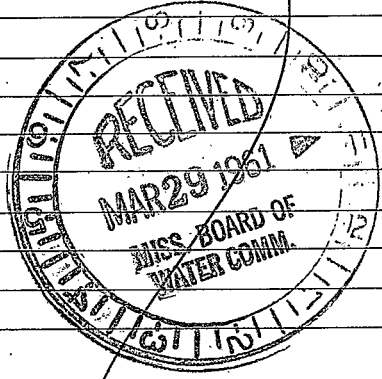

(Use Back Side)

Well No.

