

MONROE

MISSISSIPPI BOARD OF WATER COMMISSIONERS

B 2007
4-7-62

WATER WELL DRILLERS LOG

Date: April 7, 1962, Drilled by: HERNDON WELL & SUPPLY CO. County: Monroe

P. O. Box 42

SHANNON, MISSISSIPPI

(1) Owner of Land:	Description & Color of Materials Sand, Clay, Red Clay, Shell, etc.	Thick- ness Feet	Depth Feet
(Name) P. R. Sullivan (Address) Natchitoches, Miss.	Sand & clay		0
(2) Location: 1/4, 1/4, Sec 31 T 115 R 7E 1 miles East of Natchitoches (distance) (direction) (Nearest Town)	Blue rock Gravel	30 20	
(3) Topography: Flat (Hilly) (Flat) (Level)	Bottom	180	
(4) Purpose of Well: Domestic (Domestic Irrigation Municipal, Industrial, Other)			


Information upon completion of well:

- (1) Diameter 5" inches.
- (2) Total Depth 180 feet.
- (3) Water Level 90 feet below top of ground.
- (4) Cased to 35', Size 5"
- (5) Screen: Size , Length _____
- (6) Were any formations sealed against pollution?
 yes, no.

If YES depth of formation 30 ft

Why Gravel & sand

Drillers Remarks:

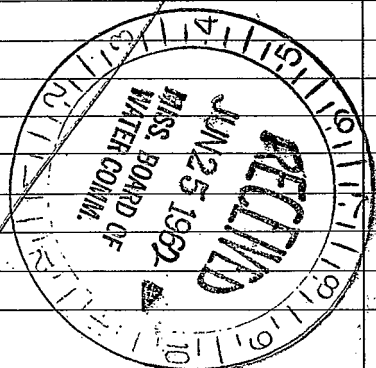

(Use Back Side)

Well No.

