

MONROE

MISSISSIPPI BOARD OF WATER COMMISSIONERS

B 2003
5-4-62

WATER WELL DRILLERS LOG

HERNDON WELL & SUPPLY CO

Date: May 4, 1962, Driller: _____ County: Monroe

P. O. BOX 42
SHANNON, MISSISSIPPI

	Description & Color of Materials Sand, Clay, Red Clay, Shell, etc.	Thick- ness Feet	Depth Feet
(1) Owner of Land: <u>Iron Hargis</u> (Name) <u>(contractor) Nettleson, Miss</u> (Address)	<u>surface sand</u>		<u>0</u>
(2) Location: <u>1/4, 1/4, Sec. 3, T. 29, R. 7E</u> <u>8</u> miles <u>SE</u> , of <u>Nettleson</u> (distance) (direction) (Nearest Town)	<u>clay</u> <u>blue sand</u>		<u>35</u>
(3) Topography: <u>Hilly</u> (Hilly) (Flat) (Level)	<u>sand</u>		<u>60</u>
(4) Purpose of Well: <u>Domestic</u> (Domestic Irrigation Municipal, Industrial, Other)	<u>Water</u>		<u>180</u>


Information upon completion of well:

- (1) Diameter 4 inches.
- (2) Total Depth 180 feet.
- (3) Water Level 60 feet below top of ground.
- (4) Cased to 35' 6", Size 4"
- (5) Screen: Size ✓, Length ✓
- (6) Were any formations sealed against pollution?
✓ yes, no.

If YES depth of formation 35' surface sand

Why _____

Drillers Remarks: _____

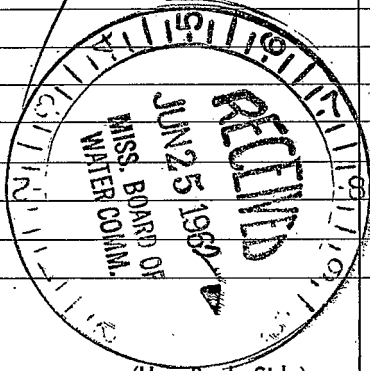

(Use Back Side)

Well No.

