

B 7004
4-25-63

WATER WELL DRILLERS LOG
HARRISON WELL & SUPPLY CO.

Date: 4/25, 1963, Driller: SHANNON, MISSISSIPPI County Monroe
(Name)

(1) Owner of Land: <u>Trag Hodges</u> (Name)	Description & Color of Materials Sand, Clay, Red Clay, Shell, etc.	Thick- ness Feet	Depth Feet
<u>(Contractor) Anthony, Men</u> (Address) EAST HAVEN DR 2568260	<u>any sand</u> <u>& clay</u>		<u>0</u>
(2) Location: <u>1/4, 1/4, Sec. 3 T. R. 74</u> <u>6</u> miles <u>SE</u> , of <u>Neelville</u> (distance) (direction) (Nearest Town)	<u>blue sand</u> <u>&</u> <u>sand</u>		<u>49</u> <u>0</u> <u>100</u>
(3) Topography: <u>flat</u> (Hilly) (Flat) (Level)	<u>to</u>		
(4) Purpose of Well: <u>Domestic</u> (Domestic Irrigation Municipal, Industrial, Other)	<u>Bottom</u>		<u>180</u>


Information upon completion of well:

- (1) Diameter 4 inches.
- (2) Total Depth 180 feet.
- (3) Water Level 70 feet below top of ground.
- (4) Cased to 51', Size 4"
- (5) Screen: Size —, Length —
- (6) Were any formations sealed against pollution?
yes, no.

If YES depth of formation 49'
Why any sand & sand

Drillers Remarks:

Description & Color of Materials Sand, Clay, Red Clay, Shell, etc.	Thick- ness Feet	Depth Feet
<u>any sand</u> <u>& clay</u>		<u>0</u>
<u>blue sand</u> <u>&</u> <u>sand</u>		<u>49</u> <u>0</u> <u>100</u>
<u>to</u>		
<u>Bottom</u>		<u>180</u>

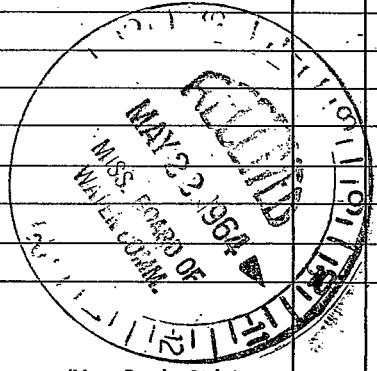

(Use Back Side)

Well No.

