

Monroe
B 205
12-22-75

MISSISSIPPI
 BOARD OF WATER COMMISSIONERS
 416 North State Street
 Jackson, Mississippi 39201

WATER WELL DRILLERS LOG

Herman Homan Well & Supply, Inc.

Monroe
 county well located

12/22
 date well completed

1975
 Firm name
 SHANNON, MISSISSIPPI 38868

LANDOWNER:
John E. Smith
Rt 2, Nettleton, Miss
 (mailing address)

description of formations encountered	from	to
<u>Indian clay</u>	<u>0</u>	<u>28</u>
<u>Blue clay</u>	<u>28</u>	<u>80</u>
<u>Sand</u>	<u>80</u>	<u>200</u>
<u>Bottom</u>	<u>200</u>	

WELL LOCATION:
 sec. 20 T. 12 N. R. 7 E.
4 miles SE of Nettleton
 (distance) (direction) (nearest town)

WELL PURPOSE:
Home
 (home, irrigation, municipal, industrial)


- WELL COMPLETION DATA:
- (1) diameter (inches) 4"
 - (2) total depth (feet) 200'
 - (3) static water level (feet) 72' below above top of ground.
 - (4) casing Steel, 348' (material) (depth)
4" (size) if telescope see back.
 - (5) screen SD (length) (depth to top)
 (size) (material)
 - (6) pump 1 (HP) 5 (yield gpm)
electric (type power)
 - (7) electric log NO (yes or no)
 (organization running log)
 - (8) how well bottom plugged open

DRILLERS REMARKS:

RECEIVED
 JAN 5 1976
 MISS. BD. OF WATER COMMISSIONERS

If well telescopes please sketch and show depths.

GROUND LEVEL

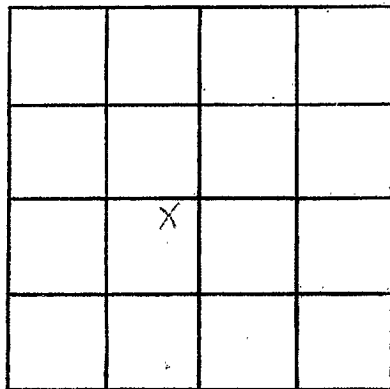

SECTION 20

Please indicate well location X.

ADDITIONAL INFORMATION

If more than one screen, show locations of each on sketch.