

**MONROE**  
**B 2006**  
**3-31-76**

MISSISSIPPI  
 BOARD OF WATER COMMISSIONERS  
 416 North State Street  
 Jackson, Mississippi 39201

**WATER WELL DRILLERS LOG**

Herman Homan Well & Supply, Inc.  
 P.O. Box 12  
 Shannon, Mississippi 38868

Monroe  
~~Lee~~

3/31/76  
 date well completed


1976

P.O. Box 12

SHANNON, MISSISSIPPI 38868

county well located


LANDOWNER:	description of formations encountered	from	to
Leewood Adkins			
Norfolkton, Miss. (mailing address)	Blue clay	25	40
WELL LOCATION:	Sand	40	170
sec. 31 T. 11 S. R. 7 E	Bottom	180	
1.5 miles NE of Norfolkton (distance) (direction) (nearest town)			
WELL PURPOSE: Home (home, irrigation, municipal, industrial)			
WELL COMPLETION DATA:			
(1) diameter (inches) 4 1/2			
(2) total depth (feet) 180			
(3) static water level (feet) 79' below top of ground.			
(4) casing steel, 30' 11" (material) (depth)			
4 1/2 (size) If telescope see back.			
(5) screen 20 (length) (depth to top)			
(size) (material)			
(6) pump 3/4 (HP) 5 (yield gpm)			
electric (type power)			
(7) electric log no (yes or no)			
(organization running log)			
(8) how well bottom plugged fine			
DRILLERS REMARKS:			

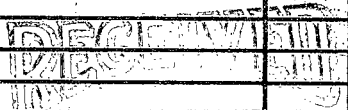

APR 07 1976

If well telescopes please sketch and show depths.

GROUND LEVEL

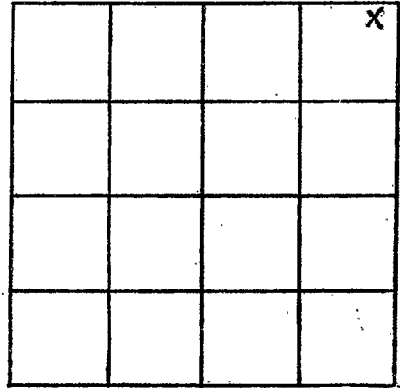

SECTION 31

Please indicate well location X.

ADDITIONAL INFORMATION

If more than one screen, show locations of each on sketch.