

MONROE
 B 2007
 5-20-76

MISSISSIPPI
 BOARD OF WATER COMMISSIONERS
 416 North State Street
 Jackson, Mississippi 39201

WATER WELL DRILLERS LOG

Herman Homan Well & Supply, Inc.

P. O. Box 42

SHANNON, MISSISSIPPI 38868


8/20 1976
 date well completed

MONROE
 county well located

LANDOWNER:	description of formations encountered	from	to
Buddy Edwards Nettleton MS (mailing address)	Sandstone sand + clay + blue clay sand	0	15 60 200
WELL LOCATION: sec. 5 T. 12 N. R. 7 E 1 miles SE of Nettleton (distance) (direction) (nearest town)	Bottle	200	
WELL PURPOSE: Home (home, irrigation, municipal, industrial)			
WELL COMPLETION DATA: (1) diameter (inches) 4 1/2 (2) total depth (feet) 200 (3) static water level (feet) 5 1/2' below top of ground. (4) casing Steel, 1 1/2" (material) (depth) 4" if telescope see back. (size) (5) screen 10 (length) (depth to top) (size) (material) (6) pump 1 1/2 (HP) 5 (yield gpm) electric (type power) (7) electric log No (yes or no) (organization running log) (8) how well bottom plugged open			
DRILLERS REMARKS:	JUN 1976 MISS. BO. OF WATER COMMISSIONERS		

If well telescopes please sketch and show depths.

GROUND LEVEL

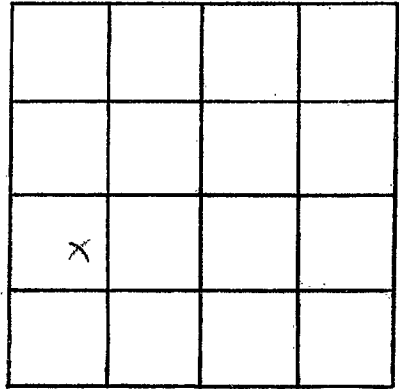

SECTION 5

Please indicate well location X.

ADDITIONAL INFORMATION

If more than one screen,
show locations of each on sketch.