

MONROE
B 2008
5-26-76

MISSISSIPPI
 BOARD OF WATER COMMISSIONERS
 416 North State Street
 Jackson, Mississippi 39201

WATER WELL DRILLERS LOG


date well completed 5-26-76 firm name Herman Homan Well & Supply, Inc. county well located Monroe
 P.O. Box 42
 SHANNON, MISSISSIPPI 38668

LANDOWNER:	description of formations encountered	from	to
<u>Charles T. Presley, Jr.</u> <u>WetHleda, MS.</u> (mailing address)			
WELL LOCATION: sec. <u>35</u> T. <u>11</u> N. R. <u>2</u> E. S. <u>4</u> miles <u>E</u> of <u>WetHleda</u> (distance) (direction) (nearest town)			
WELL PURPOSE: <u>Home</u> (home, irrigation, municipal, industrial)			
WELL COMPLETION DATA:			
(1) diameter (inches) <u>4 1/4</u>			
(2) total depth (feet) <u>110'</u>			
(3) static water level (feet) <u>20'</u> below top of ground.			
(4) casing <u>steel</u> , <u>3 1/2"</u> (material) (depth) <u>4 1/4"</u> (size) If telescope see back.			
(5) screen <u>NO</u> (length) (depth to top) (size) (material)			
(6) pump <u>3/4</u> (HP) <u>5</u> (yield gpm) <u>electric</u> (type power)			
(7) electric log <u>NO</u> (yes or no) (organization running log)			
(8) how well bottom plugged <u>open</u>			
DRILLERS REMARKS:			

MISS. Bd. of WATER COMMISSIONERS

If well telescopes please sketch and show depths.

GROUND LEVEL

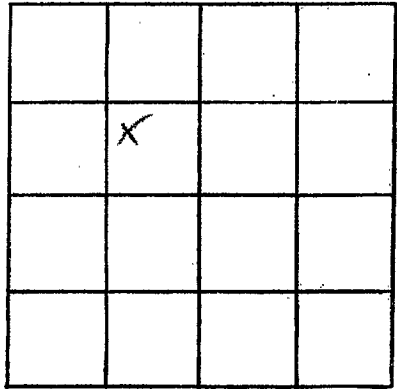

SECTION 35

Please indicate well location X.

ADDITIONAL INFORMATION

If more than one screen,
show locations of each on sketch.