

Monroe
B 2009
6-18-76

MISSISSIPPI
 BOARD OF WATER COMMISSIONERS
 416 North State Street
 Jackson, Mississippi 39201

WATER WELL DRILLERS LOG

6-18 1976 Herman Homan Well & Supply, Inc. Monroe
 date well completed firm name county well located
 P. O. Box 42
 SHANNON, MISSISSIPPI 38868

LANDOWNER:
Reldon Mills
Mr. Nettleton
 (mailing address)

description of formations encountered	from	to
<u>surface sand</u>	<u>0</u>	<u>14</u>
<u>+ clay</u>	<u>14</u>	<u>20</u>
<u>blue clay</u>	<u>20</u>	<u>120</u>
<u>Sand</u>	<u>120</u>	
<u>Bottom</u>		

WELL LOCATION:
 sec. 4 T. 52 N. R. 7 E.
2 miles SE of Nettleton
 (distance) (direction) (nearest town)

WELL PURPOSE: Home
 (home, irrigation, municipal, industrial)

- WELL COMPLETION DATA:
- (1) diameter (inches) 4 1/2
 - (2) total depth (feet) 120
 - (3) static water level (feet) 16 below above top of ground.
 - (4) casing steel (material) 119' (depth)
4" (size) If telescope see back.
 - (5) screen NO (length) (depth to top)
 (size) (material)
 - (6) pump NO (HP) (yield gpm)
 (type power)
 - (7) electric log NO (yes or no)
 (organization running log)
 - (8) how well bottom plugged Open


RECEIVED
 JUL 22 1976

DRILLERS REMARKS:

MISS. BD. OF WATER COM.

If well telescopes please sketch and show depths.

GROUND LEVEL

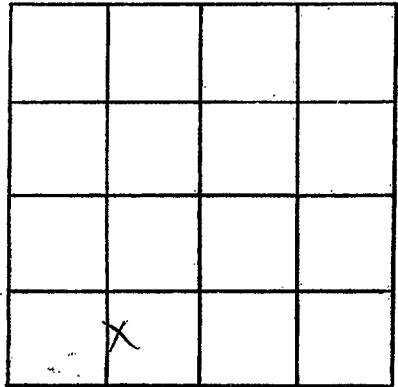

SECTION 4

Please indicate well location X.

ADDITIONAL INFORMATION

If more than one screen,
show locations of each on sketch.