

Monroe
B 2010
8/11/76

MISSISSIPPI
BOARD OF WATER COMMISSIONERS
416 North State Street
Jackson, Mississippi 39201

13C

WATER WELL DRILLERS LOG

8/11/76 date well completed 1976 Herman Homan Well & Supply, Inc. MONROE county well located
 42
 SHANNON, MISSISSIPPI 38668

LANDOWNER:
 Lloyd Burns
 Rt. Nettleton Ms.
 (mailing address)

description of formations encountered	from	to
surface sand	0	18
clay	18	25
Sand	25	140
Gravel	140	

WELL LOCATION:
 sec. 4 T. 12 N. R. 7 E.
 2 1/2 miles SE of Nettleton
 (distance) (direction) (nearest town)

WELL PURPOSE:
 Home
 (home, irrigation, municipal, industrial)


- WELL COMPLETION DATA:
- (1) diameter (inches) 4"
 - (2) total depth (feet) 140
 - (3) static water level (feet) 20' below top of ground
 - (4) casing (material) steel 24' (depth)
 4" (size) If telescope see back.
 - (5) screen (length) (depth to top)
 (size) (material)
 - (6) pump 3/4 (HP) 5 (yield gpm)
 electric (type power)
 - (7) electric log (yes or no) NO
 - (organization running log)
 - (8) how well bottom plugged o/c

DRILLERS REMARKS:

RECEIVED
 AUG 16 1976

If well telescopes please sketch and show depths.

GROUND LEVEL

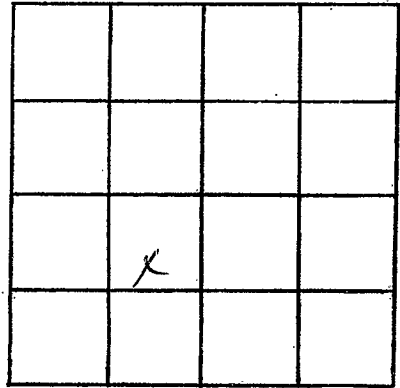

SECTION f

Please indicate well location X.

ADDITIONAL INFORMATION

If more than one screen,
show locations of each on sketch.