

Monroe
 B 2011
 8/19/76

MISSISSIPPI
 BOARD OF WATER COMMISSIONERS
 416 North State Street
 Jackson, Mississippi 39201

WATER WELL DRILLERS LOG

8/19 1976 ¹³⁰ Herman Homan Well & Supply, Inc.
 date well completed firm name

Monroe
 county well located

SHANNON MISSISSIPPI 38868

LANDOWNER:
 W.R. Hood
 Nettleton, MS
 (mailing address)

description of formations encountered	from	to
surface sand		
Blue Clay	0.18	1.8
Slip	2.5	12.0
Boiler	12.0	

WELL LOCATION:
 sec. 4 T. 22 N R. 7 E
 2.5 miles SE of Nettleton
 (distance) (direction) (nearest town)

WELL PURPOSE: Home
 (home, irrigation, municipal, industrial)

WELL COMPLETION DATA:


- (1) diameter (inches) 4.9
- (2) total depth (feet) 120'
- (3) static water level (feet) 20' below above top of ground.
- (4) casing steel, 21' (material) (depth)
 4.9 (size) if telescope see back.
- (5) screen NO (length) (depth to top)
 (size) (material)
- (6) pump NO (HP) (yield gpm)
 (type power)
- (7) electric log NO (yes or no)
 (organization running log)
- (8) how well bottom plugged open

RECEIVED
 SEP 20 1976
 MISS. Bd. OF WATER COMM.

DRILLERS REMARKS:

If well telescopes please sketch and show depths.

GROUND LEVEL

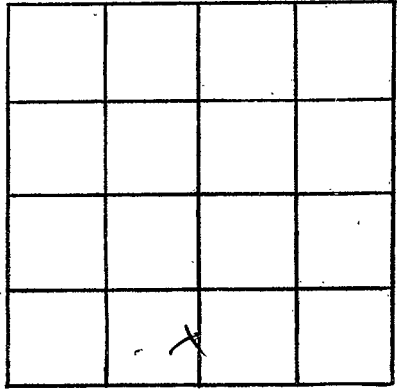

SECTION f

Please indicate well location X.

ADDITIONAL INFORMATION

If more than one screen, show locations of each on sketch.