

Monroe  
B 2012  
4-11-77

MISSISSIPPI  
BOARD OF WATER COMMISSIONERS  
416 North State Street  
Jackson, Mississippi 39201

WATER WELL DRILLERS LOG

4-11-77 date well completed 1977 Herman Homan Well & Supply, Inc. firm name  
Monroe county well located  
CHANNON MISSISSIPPI 38868

LANDOWNER:  
Freddie T. Smith  
Rt 2 Nettleson, Ms.  
(mailing address)

description of formations encountered	from	to
surface clay	0	16
blue clay	16	80
sand	80	130
gravel	130	

WELL LOCATION:  
sec. 21 T. 12 N. R. 7 E.  
S W  
5 miles SE of Nettleson  
(distance) (direction) (nearest town)

WELL PURPOSE: Home  
(home, irrigation, municipal, industrial)

- WELL COMPLETION DATA:
- (1) diameter (inches) 4 1/2
  - (2) total depth (feet) 180
  - (3) static water level (feet) 50' below top of ground.
  - (4) casing (material) steel, (depth) 20', (size) 4 1/2" if telescope see back.
  - (5) screen (length) NO (depth to top)
  - (6) pump (HP) 3/4 (material) S (yield gpm) electric (type power)
  - (7) electric log NO (yes or no)
  - (organization running log)
  - (8) how well bottom plugged open


DRILLERS REMARKS:

RECEIVED  
MAY 2 1977

MISS. BO. OF WATER COMMISSIONERS

If well telescopes please sketch and show depths.

GROUND LEVEL

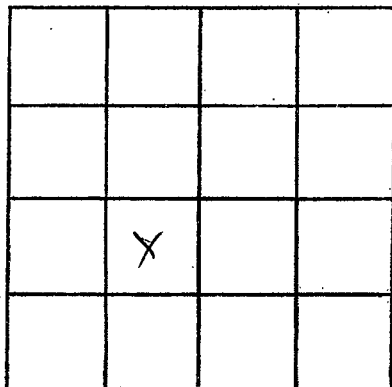

SECTION 21

Please indicate well location X.

ADDITIONAL INFORMATION

If more than one screen, show locations of each on sketch.