

Monroe
B 2013
5-26-77

MISSISSIPPI
 BOARD OF WATER COMMISSIONERS
 416 North State Street
 Jackson, Mississippi 39201

WATER WELL DRILLERS LOG

5-26 1977 Herman Homan Well & Supply, Inc. Monroe
 date well completed firm name county well located
 130 CHANNON, MISSISSIPPI 39269

LANDOWNER:
James Ricks
Nettleton, MS.
 (mailing address)

description of formations encountered	from	to
Surface sand		
Chalk	0	29
Blue clay	29	60
Sand	60	200
Bottom	200	

WELL LOCATION:
 sec. 31 T. 11 N. R. 7 E.
1 miles NE of Nettleton
 (distance) (direction) (nearest town)

WELL PURPOSE: Home
 (home, irrigation, municipal, industrial)

- WELL COMPLETION DATA:
- (1) diameter (inches) 4"
 - (2) total depth (feet) 200
 - (3) static water level (feet) 65 below top of ground.
 - (4) casing Steel, 3 1/2" (material) (depth)
4" (size) If telescope see back.
 - (5) screen 20 (length) (depth to top)
 (size) (material)
 - (6) pump 3/4 (HP) 5 (yield gpm)
electric (type power)
 - (7) electric log no (yes or no)

(organization running log)
 (8) how well bottom plugged open


DRILLERS REMARKS:

RECEIVED
 JUN 1 1977

MISS. BD. OF WATER COMMISSIONERS

If well telescopes please sketch and show depths.

GROUND LEVEL

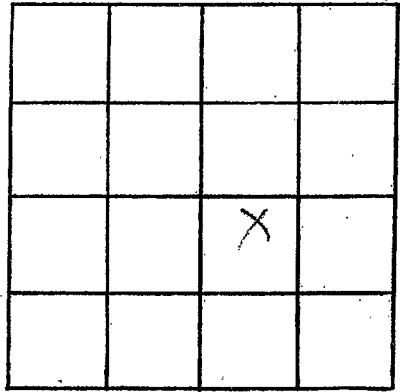

SECTION

31

Please indicate well location X.

ADDITIONAL INFORMATION

If more than one screen, show locations of each on sketch.