

Monroe
 B 2014
 6-20-77

MISSISSIPPI
 BOARD OF WATER COMMISSIONERS
 416 North State Street
 Jackson, Mississippi 39201

WATER WELL DRILLERS LOG

6-20-77 date well completed
 13C
 Herman Homan Well & Supply, Inc. firm name
 SHANNON, MISSISSIPPI 38263
 Monroe county well located

LANDOWNER:
 Charles Gington
 Rt 2 Amory, MS.
 (mailing address)

description of fomations encountered	from	to
surface sand	0	42
blue clay	42	75
sand	75	140
bottom	140	

WELL LOCATION:
 sec. 13 T 12 N R 7 E
 S W
 2 miles N of Bigbee
 (distance) (direction) (nearest town)

WELL PURPOSE:
 Home
 (home, irrigation, municipal, industrial)

- WELL COMPLETION DATA:
- (1) diameter (inches) 4"
 - (2) total depth (feet) 140'
 - (3) static water level (feet) 75' below top of ground.
 - (4) casing steel, 45' (material) (depth)
 4" (size) If telescope see back.
 - (5) screen 20' (length) (depth to top)
 (size) (material)
 - (6) pump 3/4 (HP) 5 (yield gpm)
 electric (type power)
 - (7) electric log 20 (yes or no)
 - (organization running log)
 - (8) how well bottom plugged open

DRILLERS REMARKS:


RECEIVED

JUN 25 1977

MISS. Bd. OF WATER COMMISSIONERS

If well telescopes please sketch and show depths.

GROUND LEVEL

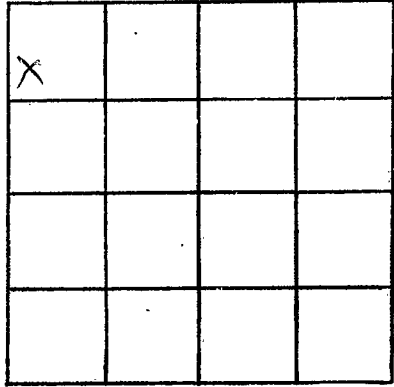

SECTION

13

Please indicate well location X.

ADDITIONAL INFORMATION

If more than one screen, show locations of each on sketch.