

MONROE
B 2015
6-24-77

MISSISSIPPI
 BOARD OF WATER COMMISSIONERS
 416 North State Street
 13C Jackson, Mississippi 39201

WATER WELL DRILLERS LOG

6-24-77 1977 Herman Homan Well & Supply, Inc. Monroe
 date well completed firm name BOX 42 county well located
 SHANNON MISSISSIPPI 38868

LANDOWNER: Milford Hall
Jettleton, MS
 (mailing address)

description of formations encountered from to
Surface sand 0 27
Blue clay 27 40
sand 40 60
Blue clay 60 88

WELL LOCATION:
 sec. 6 T 12 N R 7 E
S W
1 miles SE of Jettleton
 (distance) (direction) (nearest town)

WELL PURPOSE: Home
 (home, irrigation, municipal, industrial)

- WELL COMPLETION DATA:
- (1) diameter (inches) 5"
 - (2) total depth (feet) 160'
 - (3) static water level (feet) 60' below above top of ground.
 - (4) casing steel, 29'
 (material) (depth)
5"
 (size) If telescope see back.
 - (5) screen NO
 (length) (depth to top)
 (size) (material)
 - (6) pump NO
 (HP) (yield gpm)
 (type power)
 - (7) electric log no
 (yes or no)
 (organization running log)
 - (8) how well bottom plugged open


DRILLERS REMARKS:

RECEIVED

JUL 25 1977

If well telescopes please sketch and show depths.

GROUND LEVEL

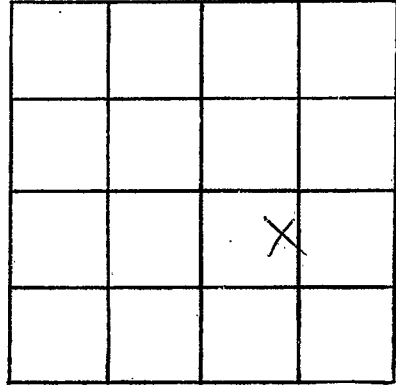

SECTION 6

Please indicate well location X.

ADDITIONAL INFORMATION

If more than one screen, show locations of each on sketch.