

Monroe
B 2016
11/18/77

MISSISSIPPI
BOARD OF WATER COMMISSIONERS
416 North State Street
Jackson, Mississippi 39201

WATER WELL DRILLERS LOG

Herman Homan Well & Supply, Inc.

P. O. Box 42

SHANNON, MISSISSIPPI 38668

Monroe
county well located

11-18-77
date well completed

LANDOWNER: Joe Budd
Herbert Louis Salk
Natchitoches, Ms.
(mailing address)

description of formations encountered	from	to
surface sand		
blue clay	2	18
same	2.5	110
bottom	110	

WELL LOCATION:
sec. 4 T. 12 N. R. 7 E
2 miles E of Natchitoches
(distance) (direction) (nearest town)

WELL PURPOSE: Home
(home, irrigation, municipal, industrial)

- WELL COMPLETION DATA:
- (1) diameter (inches) 4"
 - (2) total depth (feet) 110'
 - (3) static water level (feet) 26' above top of ground
 - (4) casing (material) Steel, (depth) 21' 4"
 - 4" (size) if telescope see back.
 - (5) screen (length) 20' (depth to top)
 - (size) (material)
 - (6) pump 3/4 (HP) 5 (yield gpm)
 - electric (type power)
 - (7) electric log NO (yes or no)
 - (organization running log)
 - (8) how well bottom plugged open

DRILLERS REMARKS:


RECEIVED

DEC 22 1977

MISS. Bd. of WATER COMM

If well telescopes please sketch and show depths.

GROUND LEVEL

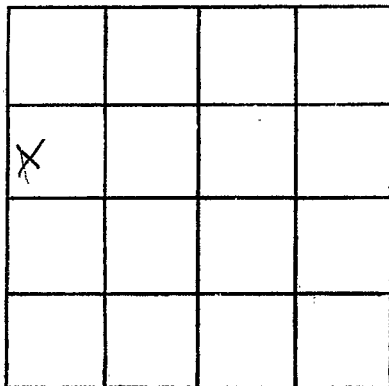

SECTION af

Please indicate well location X.

ADDITIONAL INFORMATION

If more than one screen, show locations of each on sketch.