

Monroe
 B 200
 10-30-79

MISSISSIPPI
 BOARD OF WATER COMMISSIONERS
 416 North State Street
 Jackson, Mississippi 39201

WATER WELL DRILLERS LOG

10-30-79 date well completed
 25 Herman Homan Well & Supply, Inc. firm name
 P. O. Box 42 SHANNON, MISSISSIPPI 38668
 Monroe county well located

LANDOWNER:
 Robert Duke
 Rt 4 Aberdeen, Ms
 (mailing address)

description of formations encountered	from	to
surface sand		
clay	0	95
Blanchard	75	120
Sand	120	240
Belt	240	

WELL LOCATION:
 sec 2 T 11 N R 2 E
 5 miles (distance) of Aberdeen (nearest town)

WELL PURPOSE: Home
 (home, irrigation, municipal, industrial)


- WELL COMPLETION DATA:
- (1) diameter (inches) 4"
 - (2) total depth (feet) 240'
 - (3) static water level (feet) 100' below top of ground.
 - (4) casing steel, 105' (material) (depth)
 4" (size) if telescope see back.
 - (5) screen 20' (length) (depth to top)
 (size) (material)
 - (6) pump 1/2 (HP) 5 (yield gpm)
 elect (type power)
 - (7) electric log no (yes or no)
 - (organization running log)
 - (8) how well bottom plugged open

DRILLERS REMARKS:

DEPT. OF REVENUE
 BUREAU OF LAND & REVENUE
 DEC - 7 1979
 RECEIVED

If well telescopes please sketch and show depths.

GROUND LEVEL

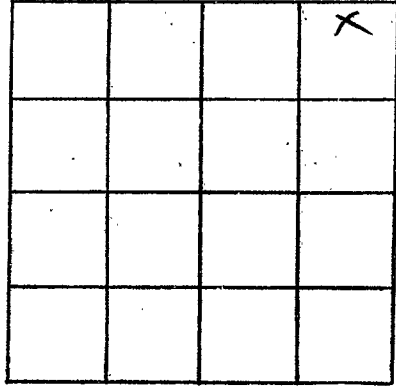

SECTION 2

Please indicate well location X.

ADDITIONAL INFORMATION

Lined area for additional information.

If more than one screen, show locations of each on sketch.