

WATER WELL DRILLERS LOG

Date: 12-8, 1960, Driller: W. J. REEVES & SON County MONROE

244-31 533-28

(Name)

(1) Owner of Land: HALD-INZER L.B.C.
 (Name)
AMORY, Miss-
 (Address)

Description & Color of Materials Sand, Clay, Red Clay, Shell, etc.	Thick- ness Feet	Depth Feet
<u>CLAY</u>	<u>17</u>	<u>0</u>
<u>SAND</u>	<u>26</u>	<u>17</u>

(2) Location: 1/4, 1/4, Sec. T R
2 miles W, of AMORY
 (distance) (direction) (Nearest Town)

(3) Topography: FLAT
 (Hilly) (Flat) (Level)

(4) Purpose of Well: DOMESTIC
 (Domestic Irrigation
 Municipal, Industrial, Other)


Information upon completion of well:

- (1) Diameter 4 inches.
- (2) Total Depth 43 feet.
- (3) Water Level 27 feet below top of ground.
- (4) Cased to 38, Size 4
- (5) Screen: Size 2 1/2, Length 5
- (6) Were any formations sealed against pollution?
 yes, no.

If YES depth of formation

Why

Drillers Remarks:

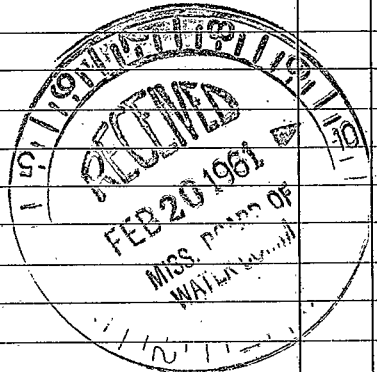

(Use Back Side)

Well No.

