

OC25

CODED

10-8-65

WATER WELL DRILLERS LOG

Herndon-Horman Well & Supply, Inc.

Date: Oct 8, 1968, Driller: P. O. Box 42 County Monroe

SHANNON, MISSISSIPPI 38868

(1) Owner of Land: Billy Hood
(Name)

At Amos, Miss.
HW 371 N. 2562228 (Address)

(2) Location: SW 1/4, SW 1/4, Sec. 6, T. 28 N., R. 10 E.
6 miles NW of Amos,
(distance) (direction) (Nearest Town)

(3) Topography: Hilly
(Hilly) (Flat) (Level)

(4) Purpose of Well: Domestic
(Domestic Irrigation
Municipal, Industrial, Other)

Description & Color of Materials Sand, Clay, Red Clay, Shell, etc.	Thick- ness Feet	Depth Feet
<u>red clay</u>		<u>0-10</u>
<u>Blue clay</u>		<u>10-68</u>
<u>red mud</u>		
<u>Blue clay</u>		<u>68-70</u>
<u>Sand</u>		<u>70-200</u>
<u>Bottom</u>		<u>200</u>

Information upon completion of well:

(1) Diameter 4 inches.

(2) Total Depth 200 feet.

(3) Water Level 60 feet below top of ground.

(4) Cased to 70'4", Size 4"

(5) Screen: Size _____, Length _____


(6) Were any formations sealed against pollution?
✓ yes, _____ no.

CODED

If YES depth of formation 68'

Why mud & sand

Drillers Remarks: _____

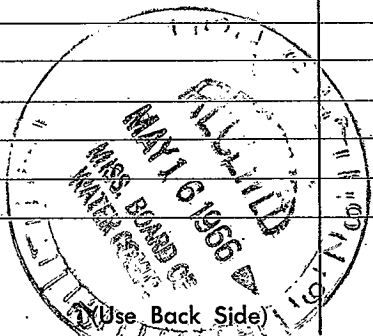

Well No.

