

CODED

CODED

CODED

CODED

Monroe
C29
12-13-68

MISSISSIPPI
BOARD OF WATER COMMISSIONERS
416 North State Street
Jackson, Mississippi 39201

WATER WELL DRILLERS LOG

12-13 1968 W.J. REEVES & SON MONROE
date well completed firm name county well located

LANDOWNER: BILLY PEARSON

Hatley Rd.
2568942

RT. 2

description of formations encountered	from to	
RED CLAY	0	19
RED SAND	19	64
BLUE CLAY	64	85
RED SAND	85	118

AMORY, Miss.
(mailing address)

WELL LOCATION:

sec 26 T 12 S R 18 E
4 miles (distance) E of AMORY (nearest town)

WELL PURPOSE: HOME
(home, irrigation, municipal, industrial)

WELL COMPLETION DATA:

- (1) diameter (inches) 4
- (2) total depth (feet) 118
- (3) static water level (feet) 27 below top of ground.
- (4) casing PVC 118 (material) (depth)
4 (size) if telescope see back.
- (5) screen 20 96' (length) (depth to top)
4 PVC (size) (material)
- (6) pump 1/2 15 (HP) (yield gpm)
- ELECT (type power)
- (7) electric log NO (yes or no)

CODED


(organization running log)

(8) how well bottom plugged SAND

DRILLERS REMARKS

If well telescopes please sketch and show depths.

GROUND LEVEL

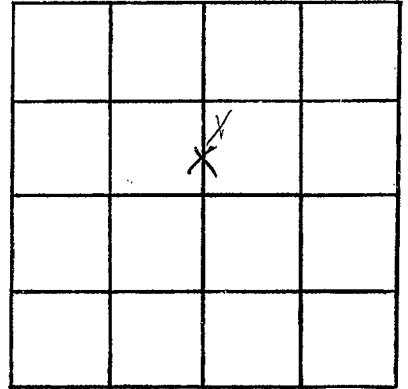

SECTION 26

Please indicate well location X.

ADDITIONAL INFORMATION

If more than one screen, show locations of each on sketch.