

MONROE  
 C 32  
 7-28-70

MISSISSIPPI  
 BOARD OF WATER COMMISSIONERS  
 416 North State Street  
 Jackson, Mississippi 39201

CODED

WATER WELL DRILLERS LOG

7-28 1970 W. J. REEVES & SON MONROE  
 date well completed 921-B 1053-9 firm name 5th L GOLD county well located CHEL

LANDOWNER: RUSSELL WYCUK

description of formations encountered	from	to
CLAY	0	16
SAND & GRAVEL	16	38
BLUE SAND	28	46
" CLAY	46	52
RED SAND	52	61
BLUE CLAY	61	85
" SAND	85	110

AMORY R+B AUTO PARTS

TOWN + COUNTRY LN 2563734  
 (mailing address)

WELL LOCATION:  
 sec. 25 T. 12 N R. 9 W  
 0 miles (distance) of AMORY (direction) (nearest town)

WELL PURPOSE: IRRIGATION  
 (home, irrigation, municipal, industrial)

WELL COMPLETION DATA:

- (1) diameter (inches) 4
- (2) total depth (feet) 110
- (3) static water level (feet) 19 below top of ground.
- (4) casing STEEL 63 (material) (depth)  
 4 (size) if telescope see back.
- (5) screen NONE (length) (depth to top)  
 (size) (material)
- (6) pump 1/2 15 (HP) (yield gpm)  
 ELECT (type power)
- (7) electric log NO (yes or no)  
 (organization running log)
- (8) how well bottom plugged OPEN

CODED


AUG 20 1970

DRILLERS REMARKS:

MISS. BD. OF WATER COM.

If well telescopes please sketch and show depths.

GROUND LEVEL

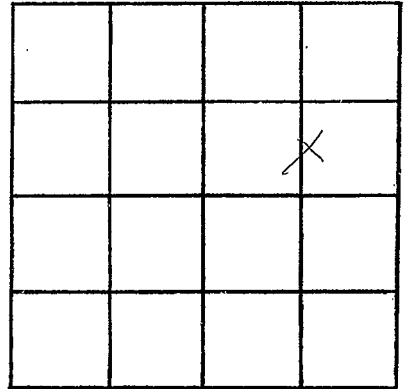

SECTION 25

Please indicate well location X.

ADDITIONAL INFORMATION

If more than one screen,  
show locations of each on sketch.