

MONROE

C 33

8-5-70

MISSISSIPPI  
 BOARD OF WATER COMMISSIONERS  
 416 North State Street  
 Jackson, Mississippi 39201

**CODED**

WATER WELL DRILLERS LOG

8-5 1970 W. J. REEVES & SON MONROE  
 date well completed firm name county well located

LANDOWNER: JACK FLOWERS

RT. 1 2562549

SMITHVILLE

(mailing address)

WELL LOCATION:

sec. 13 T. 12 R. 8 E  
 2 miles S. of SMITHVILLE  
 (distance) (direction) (nearest town)

WELL PURPOSE: STOCK  
 (home, irrigation, municipal, industrial)

WELL COMPLETION DATA:

- (1) diameter (inches) 4
- (2) total depth (feet) 156
- (3) static water level (feet) 44 below above top of ground:
- (4) casing PVC 136  
 (material) (depth)  
 4 (size) if telescope see back.
- (5) screen 20 136  
 (length) (depth to top)  
 4 PVC  
 (size) (material)
- (6) pump NONE  
 (HP) (yield gpm)  
 (type power)
- (7) electric log No  
 (yes or no)  
 (organization running log)
- (8) how well bottom plugged SAND

description of formations encountered

from

to

RED CLAY	0	14
RED CLAY & GRAVEL	14	27
BLUE CLAY	27	90
" SAND	90	98
" CLAY	98	127
WHITE SAND	127	156

**CODED**


AUG 26 1970

MISS. DD. OF  
WATER COM.

DRILLERS REMARKS:

If well telescopes please sketch and show depths.

GROUND LEVEL

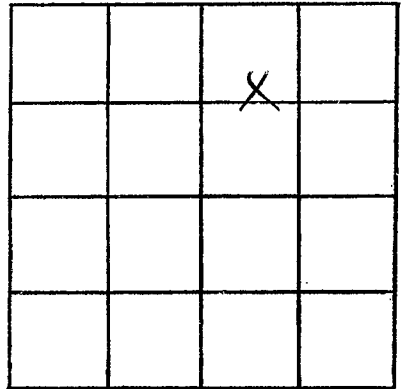

SECTION 13

Please indicate well location X.

ADDITIONAL INFORMATION

If more than one screen, show locations of each on sketch.