

MONROE
 C-35
 6-6-70

MISSISSIPPI
 BOARD OF WATER COMMISSIONERS
 416 North State Street
 Jackson, Mississippi 39201

CODED

WATER WELL DRILLERS LOG

10-6 1970 W. J. REEVES & SON MONROE
 date well completed firm name county well located

LANDOWNER: H. T. CARTER

description of formations encountered

from to

RT. 2

RED CLAY 0 16
 RED SAND 16 110
 BLUE CLAY 110 112

AMORY
 (mailing address)

WELL LOCATION:
 36 sec. 12 T. 18 R. 9
5 miles E of Amory
 (distance) (direction) (nearest town)

WELL PURPOSE: HOME
 (home, irrigation, municipal, industrial)

WELL COMPLETION DATA:

- (1) diameter (inches) 4
- (2) total depth (feet) 112
- (3) static water level (feet) 40 below above top of ground:
- (4) casing PVC 92
 (material) (depth)
- 4 If telescope see back.
 (size)
- (5) screen 20 92
 (length) (depth to top)
- 4 PVC
 (size) (material)
- (6) pump _____
 (HP) (yield gpm)
- (type power) _____
- (7) electric log NO
 (yes or no)
- (organization running log) _____

CODED

(8) how well bottom plugged SAND


AUG 26 1970

DRILLERS REMARKS:

MISS. BD. OF
 WATER COMM.

If well telescopes please sketch and show depths.

GROUND LEVEL

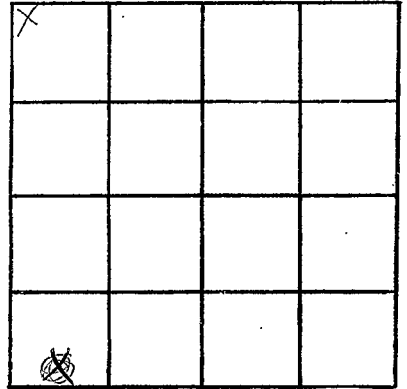

SECTION ³⁶~~25~~

Please indicate well location X.

ADDITIONAL INFORMATION

Lined area for additional information.

If more than one screen, show locations of each on sketch.