

MONROE

C36

2-9-71

MISSISSIPPI
 BOARD OF WATER COMMISSIONERS
 416 North State Street
 Jackson, Mississippi 39201

CODED

WATER WELL DRILLERS LOG

2-9 date well completed 19 71 W. J. REEVES & SON firm name MONROE county well located

Green to on 12

LANDOWNER: RANDE CRAY

Hatley-Detroit Rd.

Rt. 2 250 3107

description of formations encountered

from

to

AMORY

(mailing address)

RED CLAY 0 24
 RED CLAY & SAND 24 86
 BLUE CLAY 86 120
 BLUE CLAY & SAND 120 162
 BLUE CLAY 162 220
 WHITE SAND 220 260

WELL LOCATION:

sec. 34 T. 12 S. R. 18 E. 18
 5 miles E of AMORY
 (distance) (direction) (nearest town)

WELL PURPOSE: HOME
 (home, irrigation, municipal, industrial)

WELL COMPLETION DATA:

- (1) diameter (inches) 4
- (2) total depth (feet) 260
- (3) static water level (feet) 152 below top of ground.
- (4) casing PVC 240 (material) (depth)
- 4 (size) if telescope see back.
- (5) screen 20' 240 (length) (depth to top)
- 4' PVC (size) (material)
- (6) pump 1 1/2 20 (HP) (yield gpm)
- ELECT (type power)
- (7) electric log No (yes or no)

(organization running log)

(8) how well bottom plugged SAND

DRILLERS REMARKS:


CODED

MAR 16 1971

MISS. Bd. of Water Comm.

If well telescopes please sketch and show depths.

GROUND LEVEL

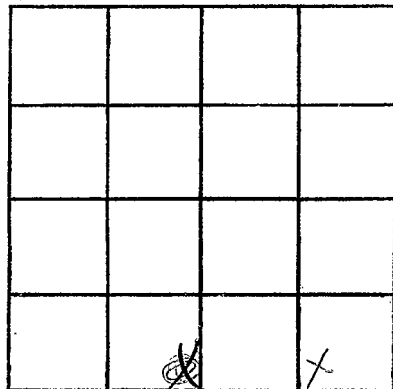

SECTION 24

Please indicate well location X.

ADDITIONAL INFORMATION

If more than one screen, show locations of each on sketch.