

MONROE

MISSISSIPPI BOARD OF WATER COMMISSIONERS

C 38

Co. 26

7-26-65

WATER WELL DRILLERS LOG

Date: July 26, 1965, Driller: Layne-Central Co. County: Monroe

(Name)

(1) Owner of Land: True Temper Corp.

(Name)

Amory, Miss.

(Address)

(2) Location: SW SE 1/4, Sec. 36 T12R19W

miles of (distance) (direction) (Nearest Town)

(3) Topography:

(Hilly) (Flat) (Level)

(4) Purpose of Well: Industrial

(Domestic Irrigation Municipal, Industrial, Other)

Information upon completion of well:

(1) Diameter 16 inches.

(2) Total Depth 315 feet.

(3) Water Level ? feet below top of ground.

(4) Cased to 254', Size 10"

(5) Screen: Size 10", Length 60'

(6) Were any formations sealed against pollution?

x yes, no.

If YES depth of formation 254'

Why required

Drillers Remarks:

Description & Color of Materials Sand, Clay, Red Clay, Shell, etc.

Thickness Feet

Depth Feet

yellow clay 12 12

gravel 9 21

blue clay 16 37

sand, gravel & clay 9 46

sand-gravel 10 56

sand 10 66

sand-gravel 5 71

white hard chalk-clay 6 77

blue clay 19 96

sand-clay 5 101

blue clay 20 121

blue hard clay like rock 2 123

blue clay 4 127

black clay 1 128

blue clay 25 153

sand 3 156

sand-soft lime rock 10 166

sand 25 191

blue clay 2 193

sand 5 198

blue clay 13 211

blue sandy clay 17 228

gravel 8 236


sand-gravel 25 261

rock hard-soft stk. 5 266

gravel 3 269

hard rock 4 273

gravel-sand & boulders 46 319

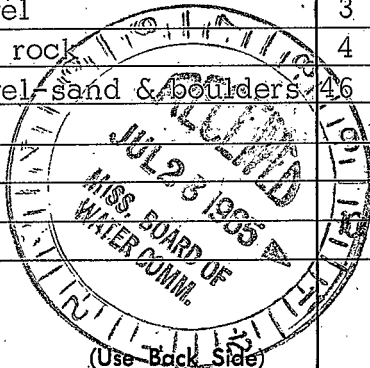

Well No.

(x)