

Coded

10/12/71

Monroe

C40

5-67

MISSISSIPPI BOARD OF WATER COMMISSIONERS
416 North State Street
Jackson, Mississippi 39201

CODED

WATER WELL DRILLERS LOG

5-15

1967 W.J. REEVES & SON

MONROE

date well completed

firm name

county well located

LANDOWNER: AMORY CARMENT CO

description of formations encountered

from to

So. MAIN

CLAY	0	15
SAND & GRAVEL	15	24
BLUE CLAY	24	27
" SAND	27	86

Amory

(mailing address)

WELL LOCATION:

sec 36 T. 12 N. R. 19 E.
0 miles of Amory
(distance) (direction) (nearest town)


WELL PURPOSE: IRR.
(home, irrigation, municipal, industrial)

WELL COMPLETION DATA:

- (1) diameter (inches) 4
- (2) total depth (feet) 86
- (3) static water level (feet) 12 below top of ground.
- (4) casing PVC, 46
(material) (depth)
4 if telescope see back.
(size)
- (5) screen 40', 46
(length) (depth to top)
4", PVC
(size) (material)
- (6) pump I, 15
(HP) (yield gpm)
ELECT
(type power)
- (7) electric log NO
(yes or no)

(organization running log)
- (8) how well bottom plugged SAND

CODED

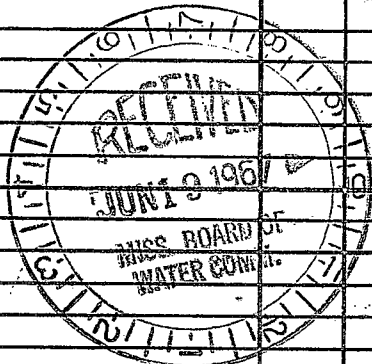

DRILLERS REMARKS:

If well telescopes please sketch and show depths.

GROUND LEVEL

			X

SECTION 36

Please indicate well location X.

ADDITIONAL INFORMATION

If more than one screen,
show locations of each on sketch.