

MISSISSIPPI
BOARD OF WATER COMMISSIONERS
416 North State Street
Jackson, Mississippi 39201

CODED

WATER WELL DRILLERS LOG

Memor
C 41
6-67

6-21 19**68** W. J. REEVES & SON MONROE
date well completed firm name county well located

LANDOWNER: C. L. FIELDS

description of formations encountered

from to

RT. 2 Hatley Rd.
2565429

AMORY, Miss
(mailing address)

RED CLAY 0 34
RED SAND 34 104
BLUE CLAY 104 106

WELL LOCATION:

sec. 32 T. 12 S. R. 18
1 miles E of AMORY
(distance) (direction) (nearest town)

WELL PURPOSE: HOME
(home, irrigation, municipal, industrial)

WELL COMPLETION DATA:

(1) diameter (inches) 4
(2) total depth (feet) 106
(3) static water level (feet) 39 below top of ground.

CODED

(4) casing PVC, 86,
(material) (depth)
4" if telescope see back.
(size)

(5) screen 20, 86
(length) (depth to top)
4", PVC
(size) (material)

(6) pump 1/2, 10
(HP) (yield gpm)
ELECT
(type power)

(7) electric log No
(yes or no)

(organization running log)

(8) how well bottom plugged SAND


JUN 24 1968
MISS. BD. OF
WATER COMME.

DRILLERS REMARKS:

9 1/2" DRILL HOLE
GRAVEL PACKED

If well telescopes please sketch and show depths.

GROUND LEVEL

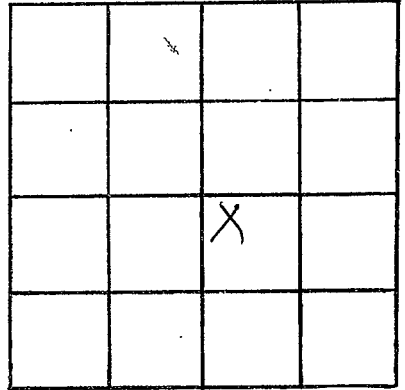

SECTION 32

Please indicate well location X.

ADDITIONAL INFORMATION

If more than one screen, show locations of each on sketch.