

MONROE

DC43

MISSISSIPPI BOARD OF WATER COMMISSIONERS

4-14-66

WATER WELL DRILLERS LOG

CODED

Date: 4-14, 1966, Driller: J.C. REEVES County: MONROE

(When well drilled) 593-6 (Name) (Where well is located)

(1) Owner of Land: HARRY SUGG (Name)

RT. 3, AMORY (Address)

(2) Location: NE 1/4, NE 1/4, Sec. 25 T12R18

5 miles E of HATLEY (distance) (direction) (Nearest Town)

(3) Topography: HILLY (Hilly) (Flat) (Level)

(4) Purpose of Well: DOMESTIC (Domestic Irrigation) (Municipal, Industrial, Other)

Description & Color of Materials Sand, Clay, Red Clay, Shell, etc.	Thick- ness Feet	Depth Feet
RED CLAY	25	
RED SAND	56	25
BLUE CLAY	4	81
GREY SAND	12	85

CODED

Information upon completion of well:

(1) Diameter: 4 inches.

(2) Total Depth: 97 feet.

(3) Water Level: 55 feet below top of ground.

(4) Cased to: 85', Size: 4" PVC

(5) Screen: Size: 4", Length: 12'

(6) Were any formations sealed against pollution?

yes, no.

If YES depth of formation


Why

Drillers Remarks:

Yield in gpm: 10

Size pump: 1/2 H.P. SUB

Type power: ELECTRIC

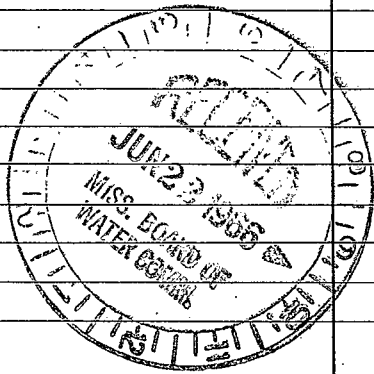

[The page contains extremely faint and illegible text, likely bleed-through from the reverse side of the document. The text is too light to transcribe accurately.]