

C45

7-9-62

WATER WELL DRILLERS LOG CODED

Date: 7-9, 1962, Driller: J. C. Reeves County Monroe

460-3 lumber yard

(Name)

(1) Owner of Land: F. S. REEVES

(Name)

AMORY, MISS
HW25 S. 2565055 (Address)

(2) Location: SE 1/4, SW 1/4, Sec. 36 T12S R19W

0 miles, of AMORY
(distance) (direction) (Nearest Town)

(3) Topography: LEVEL
(Hilly) (Flat) (Level)

(4) Purpose of Well: DOM.
(Domestic Irrigation
Municipal, Industrial, Other)

Description & Color of Materials
Sand, Clay, Red Clay, Shell, etc.

Thick-
ness
Feet

Depth
Feet

CLAY

10

0

SAND & GRAVEL

17

17

BLUE CLAY

16

31

BLUE SAND (SOFT)

18

47

BLUE CLAY

9

65

1" SAND

5

74

1" CLAY

8

79

1" SAND

12

87

1" CLAY

14

99

1" SAND

22

113

Information upon completion of well:

(1) Diameter 4 inches.

(2) Total Depth 135 feet.

(3) Water Level 5 feet below top of ground.

(4) Cased to 369, Size 4"

(5) Screen: Size _____, Length _____

(6) Were any formations sealed against pollution?


yes, no.

If YES depth of formation _____

Why _____

Drillers Remarks: _____

CODED

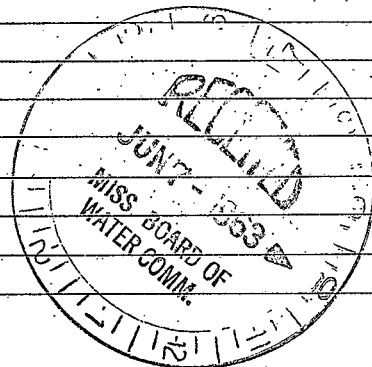

(Use Back Side)

Well No.

[The following text is extremely faint and largely illegible. It appears to be a multi-paragraph document, possibly a letter or a report, with several lines of text per paragraph. The content is too light to transcribe accurately.]