

MONROE

C46

MISSISSIPPI BOARD OF WATER COMMISSIONERS

12-8-65

WATER WELL DRILLERS LOG

CODED

Date: 12-8, 1965, Driller: J.C. REEVES County MONROE

(When well drilled) 559-3 788-2 1143-1

(Name)

(Where well is located)

(1) Owner of Land: RAY DILL  
(Name)

AMORY  
(Address)

HWGN: 256 3216

(2) Location: SE 1/4, E-NE 1/4, Sec. 26 T12R19W  
1/2 miles NW of AMORY  
(distance) (direction) (Nearest Town)

(3) Topography: FLAT  
(Hilly) (Flat) (Level)

(4) Purpose of Well: TRAILER PARK  
(Domestic Irrigation  
Municipal, Industrial, Other)

Description & Color of Materials Sand, Clay, Red Clay, Shell, etc.	Thick- ness Feet	Depth Feet
<u>S&amp;L</u>	<u>1</u>	
<u>GREY CLAY</u>	<u>22</u>	<u>1</u>
<u>WHITE SAND</u>	<u>20</u>	<u>23</u>

Information upon completion of well:

(1) Diameter 4 inches.

(2) Total Depth 43 feet.

(3) Water Level 2 feet below top of ground.

(4) Cased to 31', Size 4" PVC

(5) Screen: Size 4", Length 12'

(6) Were any formations sealed against pollution?  
\_\_\_\_\_ yes, \_\_\_\_\_ no.

CODED

If YES depth of formation \_\_\_\_\_


Why \_\_\_\_\_

Drillers Remarks: \_\_\_\_\_

Yield in gpm: 20

Size pump: 1 H.P. JET

Type power: ELECTRIC

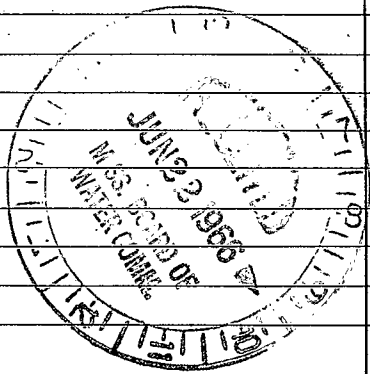

[The page contains extremely faint and illegible text, likely bleed-through from the reverse side of the document. The text is too light to transcribe accurately.]