

MONROE
C47
10-66

MISSISSIPPI BOARD OF WATER COMMISSIONERS

CODED

WATER WELL DRILLERS LOG

ON 371 N. of Bigbee 1/2 mi. Past COW SQUARE on left between BLACK BT HO & TR,

Date: Oct 26, 1966, Driller: Hendon-Homan Well & Supply, Inc. County: MONROE

(When well drilled) P. O. Box 42 (Where well is located)

(1) Owner of Land: Herchel Hood
HW 371 N. (Name)
2568939

Amory, Miss
SW SW SW (Address)
SE 1/4, SE 1/4, Sec. 36 T1 R8 S8

(2) Location: SE 1/4, SE 1/4, Sec. 36 T1 R8 S8
5/8 miles N, of Amory
(distance) (direction) (Nearest Town)

(3) Topography: Hilly
(Hilly) (Flat) (Level)

(4) Purpose of Well: Home
(Domestic Irrigation
Municipal, Industrial, Other)

Description & Color of Materials Sand, Clay, Red Clay, Shell, etc.	Thick- ness Feet	Depth Feet
<u>surface sand & clay</u>	<u>60</u>	<u>60</u>
<u>blue clay</u>	<u>05</u>	<u>65</u>
<u>Sand</u>	<u>65</u>	<u>120</u>
<u>Bottom</u>	<u>120</u>	

CODED

Information upon completion of well:

(1) Diameter: 4 inches.

(2) Total Depth: 120 feet.

(3) Water Level: _____ feet below top of ground.

(4) Cased to: 65' 6", Size: 4"

(5) Screen: Size: none, Length: _____

(6) Were any formations sealed against pollution?
yes, _____ no.

If YES depth of formation: 60


Why: surface & sand

Drillers Remarks: By Others

Yield in gpm: _____

Size pump: _____

Type power: _____

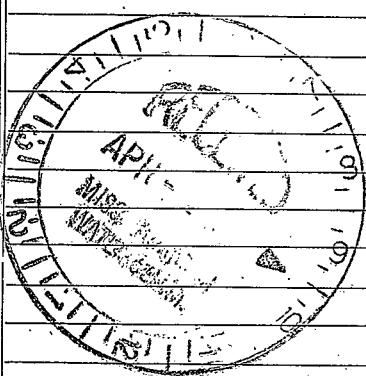

[The page contains extremely faint and illegible text, likely bleed-through from the reverse side of the document. The text is too light to transcribe accurately.]