

MONROE

MISSISSIPPI BOARD OF WATER COMMISSIONERS

C 48
4-19-61

WATER WELL DRILLERS LOG

CODED

Date: 4-19, 1961, Driller: J. C. REEVES County MONROE
(Name)

| (1) Owner of Land: | Description & Color of Materials Sand, Clay, Red Clay, Shell, etc. | Thick- ness Feet | Depth Feet |
|--|---|------------------------|---------------|
| (Name) NETTLETON HUNTING & FISHING CLUB | CLAY | 13 | 0 |
| (Address) AMORY MISS | RED SAND | 115 | 13 |
| (2) Location: SW 1/4, SE 1/4, Sec. 5 T12R8, 5 miles NORTH of AMORY (distance) (direction) (Nearest Town) | | | |
| (3) Topography: HILLY (Hilly) (Flat) (Level) | | | |
| (4) Purpose of Well: DOMESTIC (Domestic Irrigation Municipal, Industrial, Other) | | | |

CODED


Information upon completion of well:

- (1) Diameter 4 inches.
- (2) Total Depth 128 feet.
- (3) Water Level 50 feet below top of ground.
- (4) Cased to 118, Size 4"
- (5) Screen: Size 4, Length 10'
- (6) Were any formations sealed against pollution?
 yes, no.

If YES depth of formation _____

Why _____

Drillers Remarks: _____

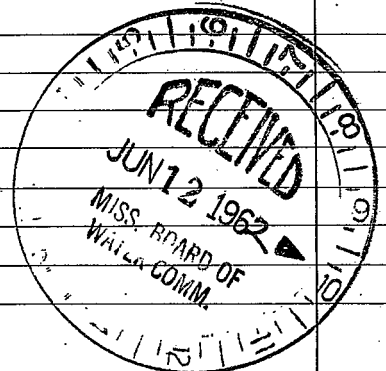

(Use Back Side)

Well No.

