

MONROE

MISSISSIPPI BOARD OF WATER COMMISSIONERS

C 50

6-9-61

WATER WELL DRILLERS LOG

CODED

Date: 6-9, 1961, Driller: J. C. REEVES County: MONROE

(Name)

18-9

Nettleton Club Lake

(1) Owner of Land: J. H. PARR

(Name)

NETTLETON, MISS.

(Address)

(2) Location: SW 1/4, SE 1/4, Sec. 6 12 8 T 28 R 10 E

5 miles NORTH of AMORY

(distance) (direction) (Nearest Town)

(3) Topography: HILLY

(Hilly) (Flat) (Level)

(4) Purpose of Well: DOM.

(Domestic Irrigation Municipal, Industrial, Other)

Information upon completion of well:

(1) Diameter 2 inches.

(2) Total Depth 93 1/2 feet.

(3) Water Level 50 feet below top of ground.

(4) Cased to 83 1/2', Size 2"

(5) Screen: Size 2", Length 10'

(6) Were any formations sealed against pollution?

yes, no.


If YES depth of formation

Why

Drillers Remarks:

Description & Color of Materials Sand, Clay, Red Clay, Shell, etc.	Thick- ness Feet	Depth Feet
CLAY	18	0
RED SAND	75	18

CODED

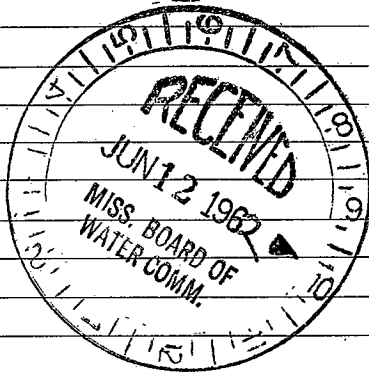

(Use Back Side)

Well No.

