

MONROE
C 71
8-11-72

MISSISSIPPI
BOARD OF WATER COMMISSIONERS
416 North State Street
Jackson, Mississippi 39201

CODED

WATER WELL DRILLERS LOG

8-11-1972 date well completed
W. J. REEVES & SON firm name
MONROE county well located

LANDOWNER: FIRST AMERICA
FARMS INC.
BIOBEE
(mailing address)

description of formations encountered	from	to
CLAY	0	10
SAND & GRAVEL	10	28

WELL LOCATION:
sec. 26 T. 12 N. R. 18 E.
3 miles NW of AMORY
(distance) (direction) (nearest town)

WELL PURPOSE: HOME
(home, irrigation, municipal, industrial)

WELL COMPLETION DATA:

- diameter (inches) 2
- total depth (feet) 28
- static water level (feet) 8 below above top of ground.
- casing PVC, 23
(material) (depth)
2 if telescope see back.
(size)
- screen 5, 23
(length) (depth to top)
2, PVC
(size) (material)
- pump _____
(HP) (yield gpm)
(type power)
- electric log NO
(yes or no)
(organization running log)
- how well bottom plugged wood


CODED

FEB 12 1973

DRILLERS REMARKS:

If well telescopes please sketch and show depths.

GROUND LEVEL

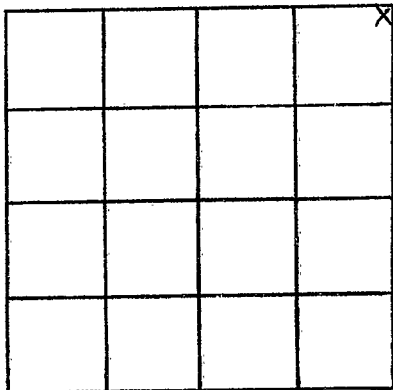

SECTION 26

Please indicate well location X.

ADDITIONAL INFORMATION

If more than one screen,
show locations of each on sketch.