

MONROE

C 74

6/74

E log 98

MISSISSIPPI  
 BOARD OF WATER COMMISSIONERS  
 416 North State Street  
 Jackson, Mississippi 39201

CODED

WATER WELL DRILLERS LOG

June 19 74 J. W. Wehl & Sons Monroe  
 date well completed firm name county well located

LANDOWNER: City of Amory

description of formations encountered	from to	
<u>SOL</u>	<u>0</u>	<u>1</u>
<u>Sand &amp; gravel</u>	<u>1</u>	<u>20</u>
<u>Sand &amp; Gravel</u>	<u>20</u>	<u>40</u>
<u>Sand &amp; Blue Rock</u>	<u>40</u>	<u>60</u>
<u>Sand &amp; Clay</u>	<u>60</u>	<u>80</u>
<u>shale + sand Blue Rock</u>	<u>80</u>	<u>100</u>
<u>Soft Blue Rock</u>	<u>100</u>	<u>120</u>
<u>Soap stone</u>	<u>120</u>	<u>140</u>
<u>Soapstone Blue Rock</u>	<u>140</u>	<u>160</u>
<u>Soapstone &amp; Sand</u>	<u>160</u>	<u>180</u>
<u>Soap stone &amp; Sand</u>	<u>180</u>	<u>200</u>
<u>Sand &amp; gravel</u>	<u>200</u>	<u>300</u>
<u>gravel</u>	<u>300</u>	<u>350</u>

Amory miss  
(mailing address)

WELL LOCATION:

sec. 26 T 125 N R 19 W E 10  
 S W  
0 miles town of Amory  
 (distance) (direction) (nearest town)

WELL PURPOSE:


(home, irrigation, municipal, industrial)

WELL COMPLETION DATA:

- (1) diameter (inches) 12"
- (2) total depth (feet) 352 ft
- (3) static water level (feet) 23 ft below top of ground.
- (4) casing steel 302 ft  
(material) (depth)
- 12 if telescope see back: 385'  
(size)
- (5) screen 50 ft 272 ft  
(length) (depth to top)
- 8" stainless steel  
(size) (material)
- (6) pump 50 HP 500  
(HP) (yield gpm)
- Elec  
(type power)
- (7) electric log yes  
(yes or no)
- MES Aug 73  
(organization running log)
- (8) how well bottom plugged Back  
wash valve

well no 1

1 1/2  
3

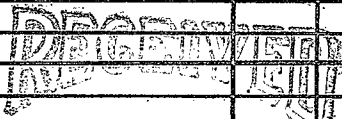

JAN 27 1975

DRILLERS REMARKS:

MISS. BD. OF WATER COMM

①

If well telescopes please sketch and show depths.

GROUND LEVEL


SECTION \_\_\_\_\_

Please indicate well location X.

ADDITIONAL INFORMATION

If more than one screen, show locations of each on sketch.