

MONROE

C75

6/74

E log #99

MISSISSIPPI  
 BOARD OF WATER COMMISSIONERS  
 416 North State Street  
 Jackson, Mississippi 39201

WATER WELL DRILLERS LOG

CODED

June 1974

J. W. Webbs Sons Monroe

date well completed

firm name

county well located

LANDOWNER: City of Amory

description of formations encountered

from to

Amory miss (mailing address)

WELL LOCATION:

sec. 26 T. 15 N R. 19 W S E (distance) (direction) (nearest town)


Soil	0	1
Red Clay & Red Sand	1	20
Gravel	20	40
Gravel & Sand	40	60
Sand & Soapstone	60	80
Sand & Clay	80	100
Shale & Sand	100	120
Soft Blue Rock	120	140
Blue Rock & Soapstone	140	160
" " "	160	180
Soapstone & Sand	180	200
Sand & Soapstone	200	220
Sand & Gravel	220	310
Gravel	310	360

WELL PURPOSE: (home, irrigation, municipal, industrial)

WELL COMPLETION DATA:

- (1) diameter (inches) 12
- (2) total depth (feet) 352
- (3) static water level (feet) 6ft below top of ground.
- (4) casing Steel, 292 (material) (depth) 12 (size) if telescope see sec. 300' - 350'
- (5) screen 50, 304 (length) (depth to top) 8" (size) Stainless steel (material)
- (6) pump 50 (HP) 500 (yield gpm) Elec (type power)
- (7) electric log Yes/No? at 73. (organization running log)
- (8) how well bottom plugged Backwash valve

Well no 2

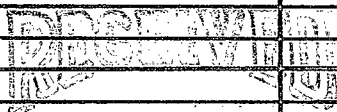

JAN 27 1975

DRILLERS REMARKS:

