

MON ROE
C 78
10-4-74

MISSISSIPPI
BOARD OF WATER COMMISSIONERS
416 North State Street
Jackson, Mississippi 39201

WATER WELL DRILLERS LOG


10-4 1974 W. J. REEVES & SON MONROE
date well completed firm name county well located

LANDOWNER: <u>MONROE CONTRACTORS</u> <u>AMORY</u>	description of formations encountered	from	to
(mailing address)	<u>CLAY</u> <u>SAND & GRAVEL</u>	<u>0</u> <u>14</u>	<u>14</u> <u>40</u>
WELL LOCATION:			
sec <u>35</u> T. <u>13</u> N. R. <u>8</u> E. S. <u>5</u> W. of <u>AMORY</u> (distance) (direction) (nearest town)			
WELL PURPOSE: <u>IND.</u> (home, irrigation, municipal, industrial)			
WELL COMPLETION DATA:			
(1) diameter (inches) <u>4</u>			
(2) total depth (feet) <u>40</u>			
(3) static water level (feet) <u>15</u> below above top of ground.			
(4) casing <u>PVC</u> , <u>30</u> , (material) (depth) <u>4</u> if telescope see back. (size)			
(5) screen <u>10</u> , <u>30</u> (length) (depth to top) <u>4</u> , <u>PVC</u> (size) (material)			
(6) pump <u>1</u> , <u>15</u> (HP) (yield gpm) <u>ELECT</u> (type power)			
(7) electric log <u>NO</u> (yes or no)			
(organization running log)			
(8) how well bottom plugged <u>SAND</u>			
DRILLERS REMARKS:			

MAR 17 1974

If well telescopes please sketch and show depths.

GROUND LEVEL

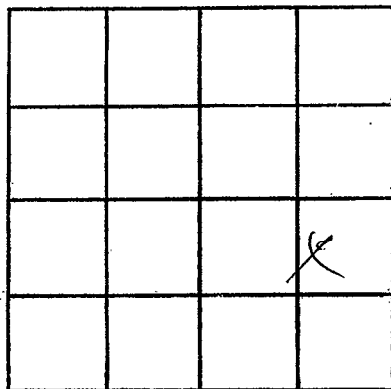

SECTION 35

Please indicate well location X.

ADDITIONAL INFORMATION

If more than one screen,
show locations of each on sketch.