

MONROE
C 79
2-5-75

MISSISSIPPI
BOARD OF WATER COMMISSIONERS
416 North State Street
Jackson, Mississippi 39201

WATER WELL DRILLERS LOG

2-5 1975 W.J. REEVES 2 SON MONROE
date well completed firm name county well located

LANDOWNER: C & F CONTRACTOR
P.O. Box 10
TUPELO
(mailing address)


description of formations encountered	from to	
	feet	feet
CLAY	0	18
SAND & GRAVEL	18	41
BLUE CLAY	41	105
" SAND	105	118
" CLAY	118	260
WHITE SAND	260	302

WELL LOCATION:
sec. 35 T 12 N R 8 E
S W
1 miles W of AMORY
(distance) (direction) (nearest town)

WELL PURPOSE: IND.
(home, irrigation, municipal, industrial)

- WELL COMPLETION DATA:
- (1) diameter (inches) 4
 - (2) total depth (feet) 302
 - (3) static water level (feet) 3 ^{below} top of ground.
 - (4) casing PVC 282
(material) (depth)
4 If telescope see back.
(size)
 - (5) screen 20 282
(length) (depth to top)
4 PVC
(size) (material)
 - (6) pump 3 80
(HP) (yield gpm)
 - FUECT
(type power)
 - (7) electric log NO
(yes or no)
 - (organization running log)
 - (8) how well bottom plugged SAND


DRILLERS REMARKS:

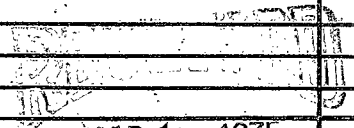

MAR 17 1975

If well telescopes please sketch and show depths.

GROUND LEVEL

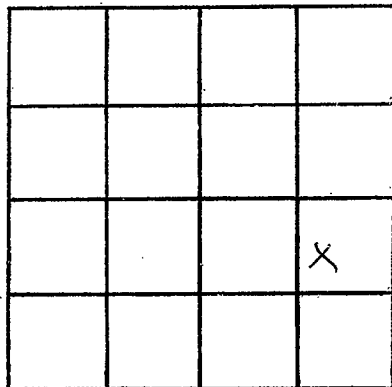

SECTION 35

Please indicate well location X.

ADDITIONAL INFORMATION

If more than one screen,
show locations of each on sketch.